


~~SEDERIS~~

MAP
CORR.

Add distances Only

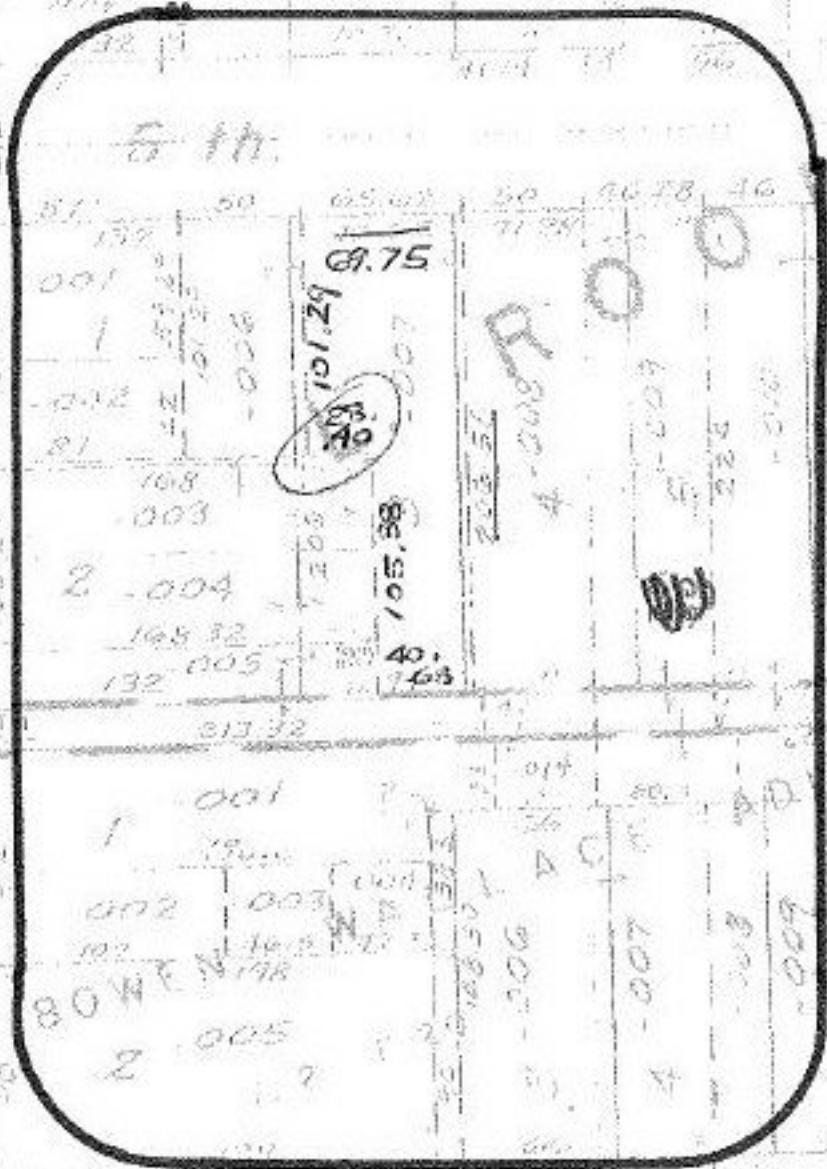

4-6-87
#17272

APPROVED	
LORAIN CO	
MAP DEPT.	
DATE	2-10-87
PRICE	6-120
BY	C. FRANCIS
FIELD NUMBER	17272

MIDDLE