


11-50-87 Q

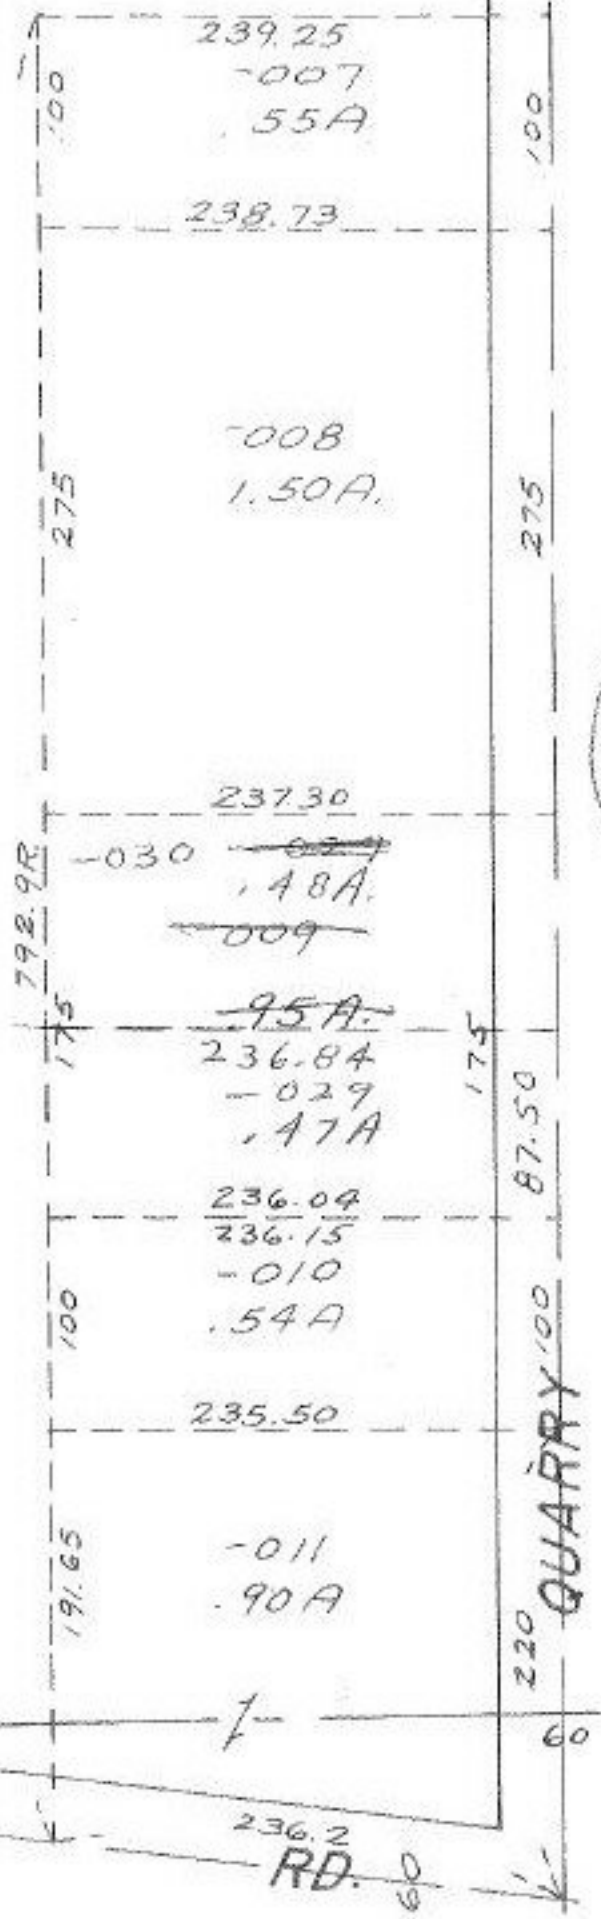

7-15-86 L.L.
 #1728
APPROVED
 LORAIN CO.
 MAP DEPT.
 DATE 5-1-68
 5-00-95-13
 BY
 D. Maynard

Done 7-6-68 LWH