

1729

412.50

419.48


E 7MAKER 50 60?

81.11

80

6-1-87 106

#1729
APPROVED
LORAIN CO.
MAP DEPT.
 DATE 5-2-68
 400-028 E
 BY
A. Maynard

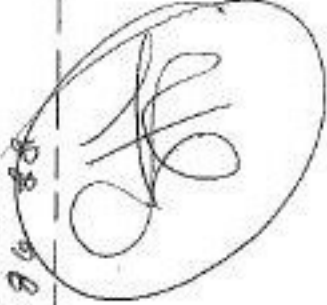

7-15-89 88

-047
6.12 A.

~~5.002~~
~~8.00 A.~~

300
-006
.57 A.

-007
-55 A.

81.73

80

-023
7.5 A.

455.14

-046

1.88 A.

INTERSTATE 90

294.21

102

102.36

412.50

Done by W.A. Kerkis 6/8/68

-024
3.34 A.