

MICHELLE

SEE

PLUM CREEK


66

SEE 12-0

2/26

SEE 12-0

COMBINATION

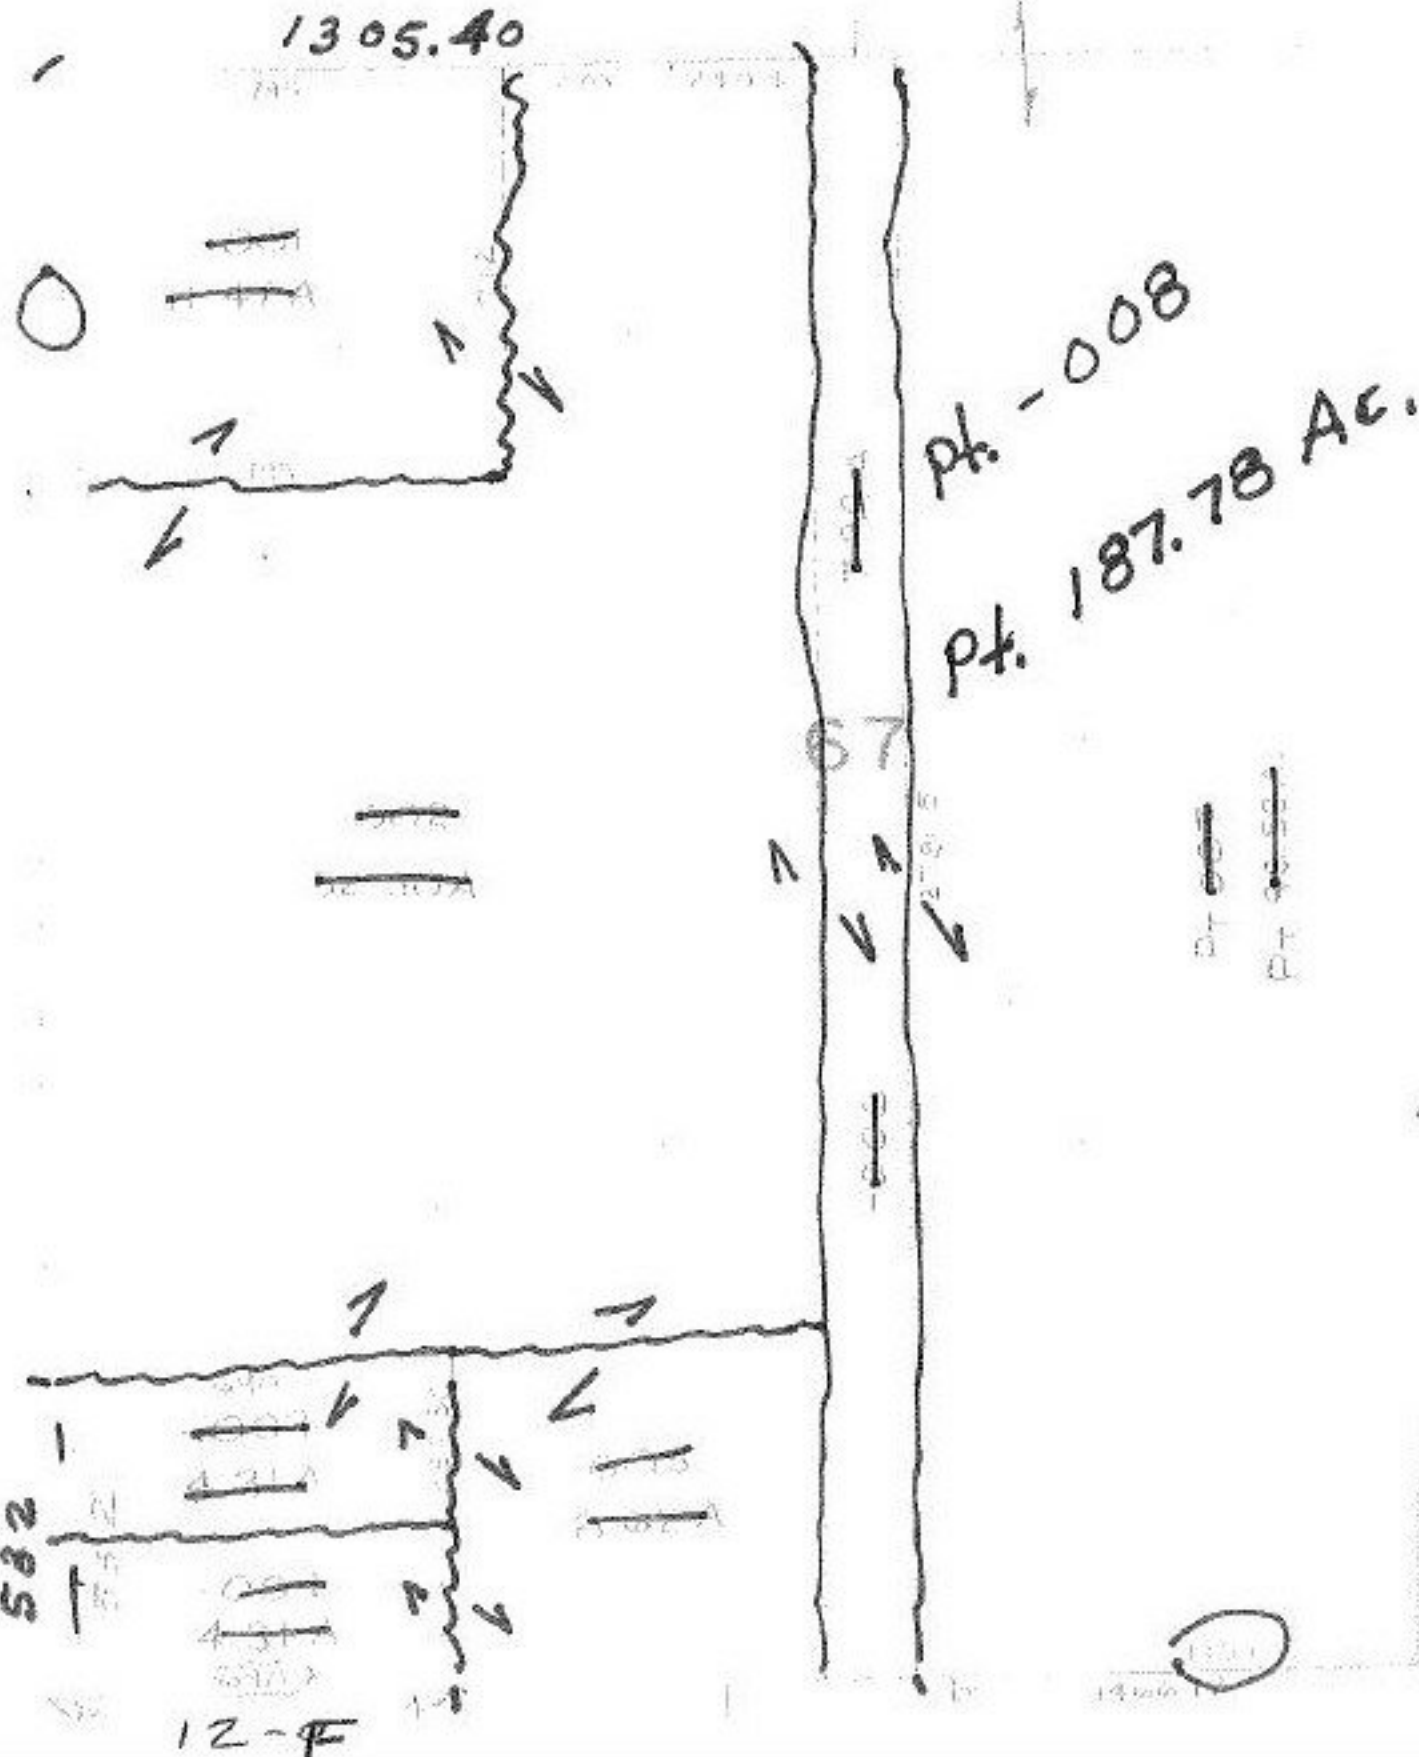

| | |
|----------|---------|
| 001 | 11.47 A |
| 002 | 52.50 A |
| 003 | 4.31 A |
| 004 | 4.31 A |
| 005 | 36.2 A |
| 006 | 7.79 A |
| 007 | 98.58 A |
| 187.78 A | |

PC 7-21-87

SEE 12-00-05

#17292

APPROVED
LORAIN CO.
MAP DEPT.

DATE 2-26-87

PAGE 12-F

BY [Signature]

VOID AFTER [Signature]