


23rd ST.

SEE 2-01-003-H

02-00-093-107-
PRIOR Deed VOL. 1110 Pg. 404
Sublot, C & I: INF
Survey BY V.C. McGervey
Reg. Surveyor

Pt. 02-01-003-182-023
V.C. McGervey
Reg. Surveyor

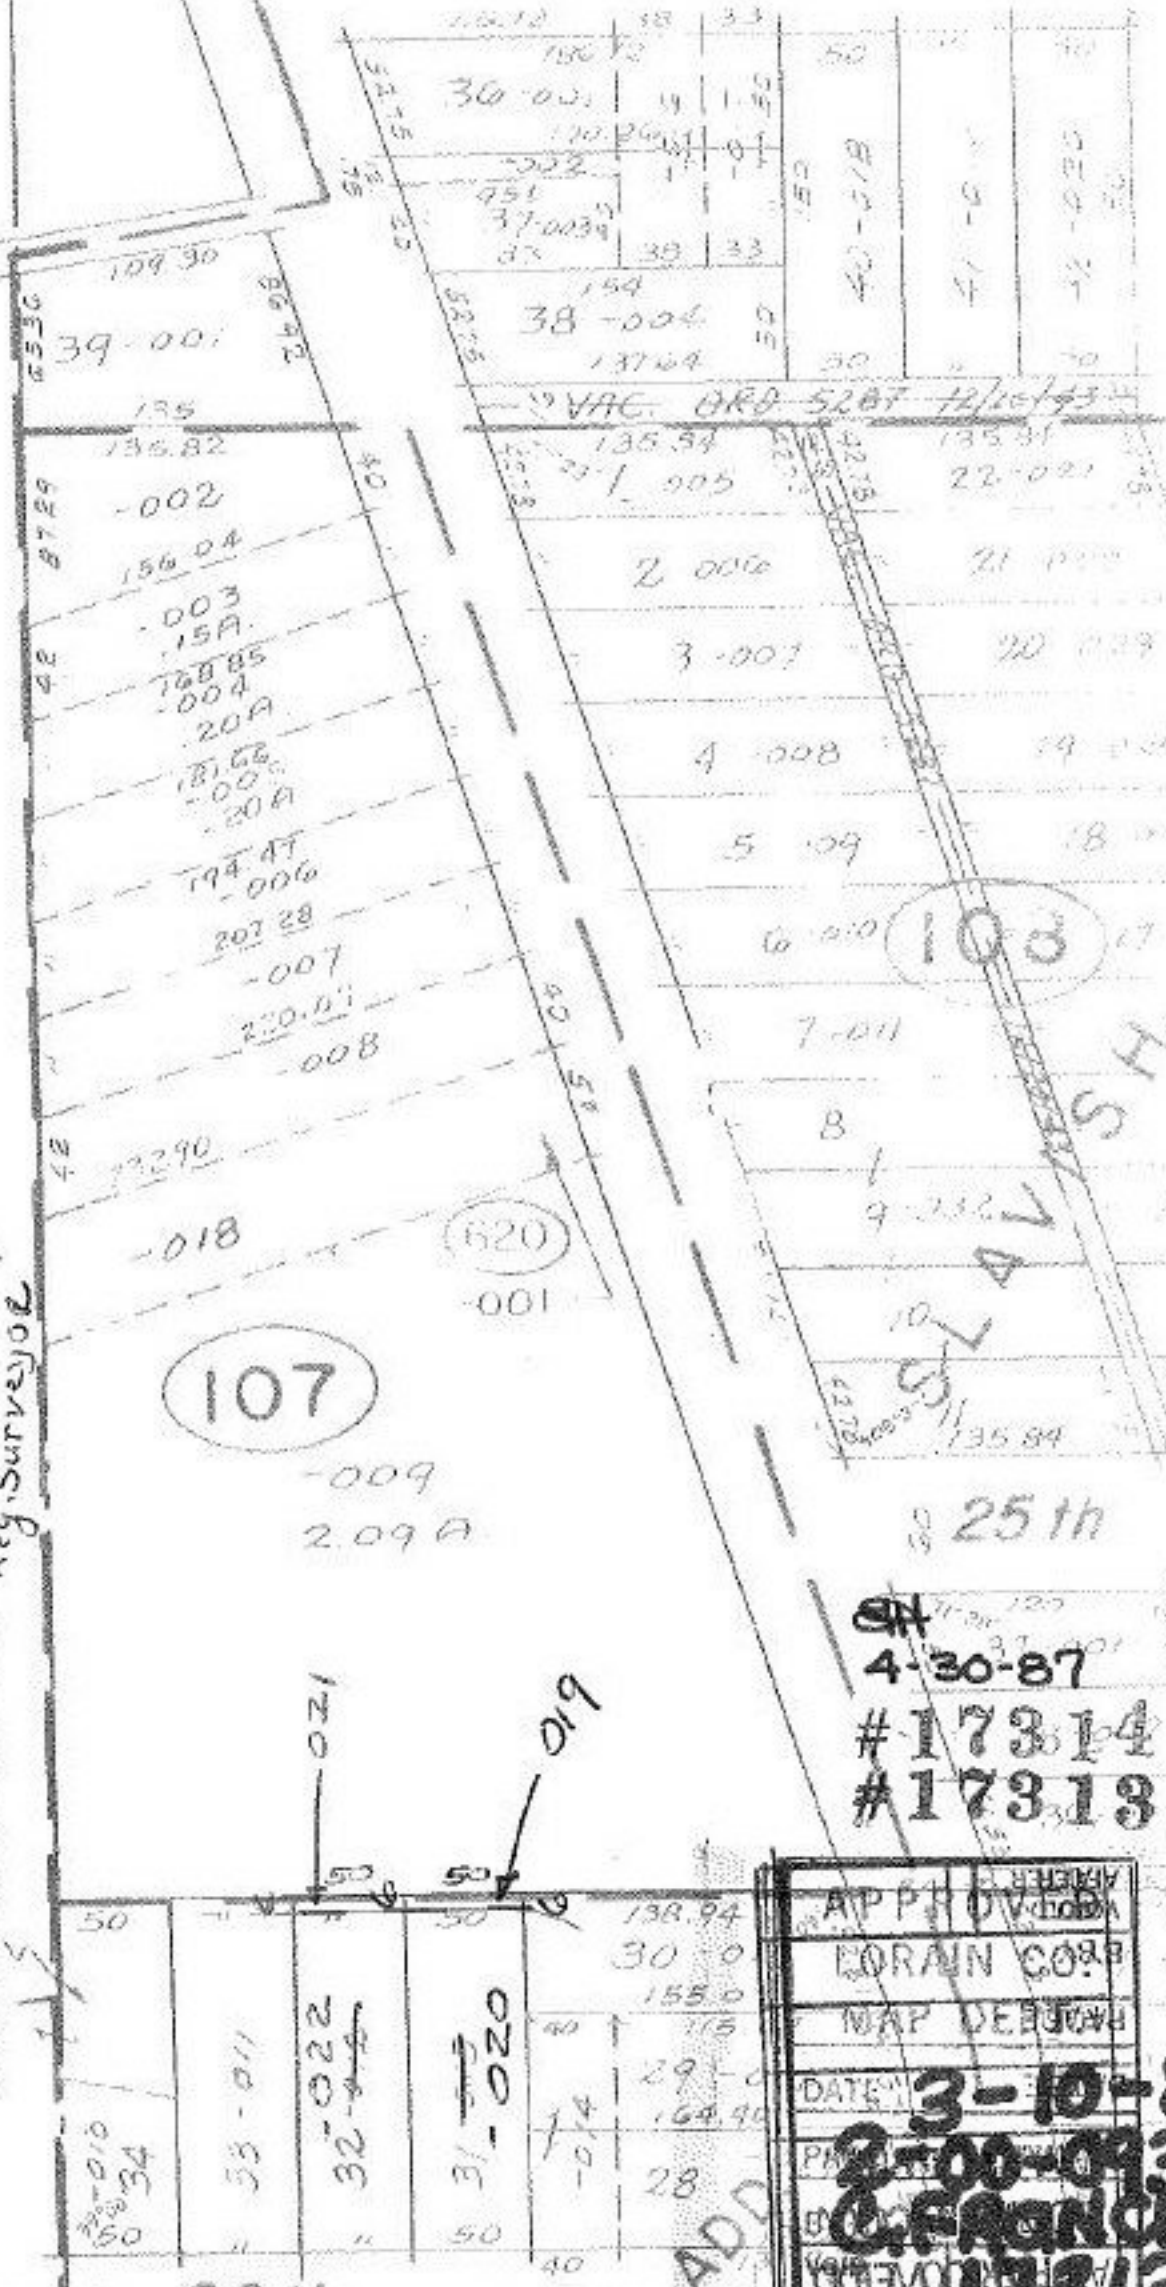

4-30-87
#17314
#17313

APPROVED
MORAIN CO. BLDG
MAP DEPT
DATE 3-10-87
PROJECT 02-00-093B
C. FRANKS
17313

ADD

107

108

620

209A

018

021

019

26th

25th