


6-4-87 03



-001
15.00 FT.

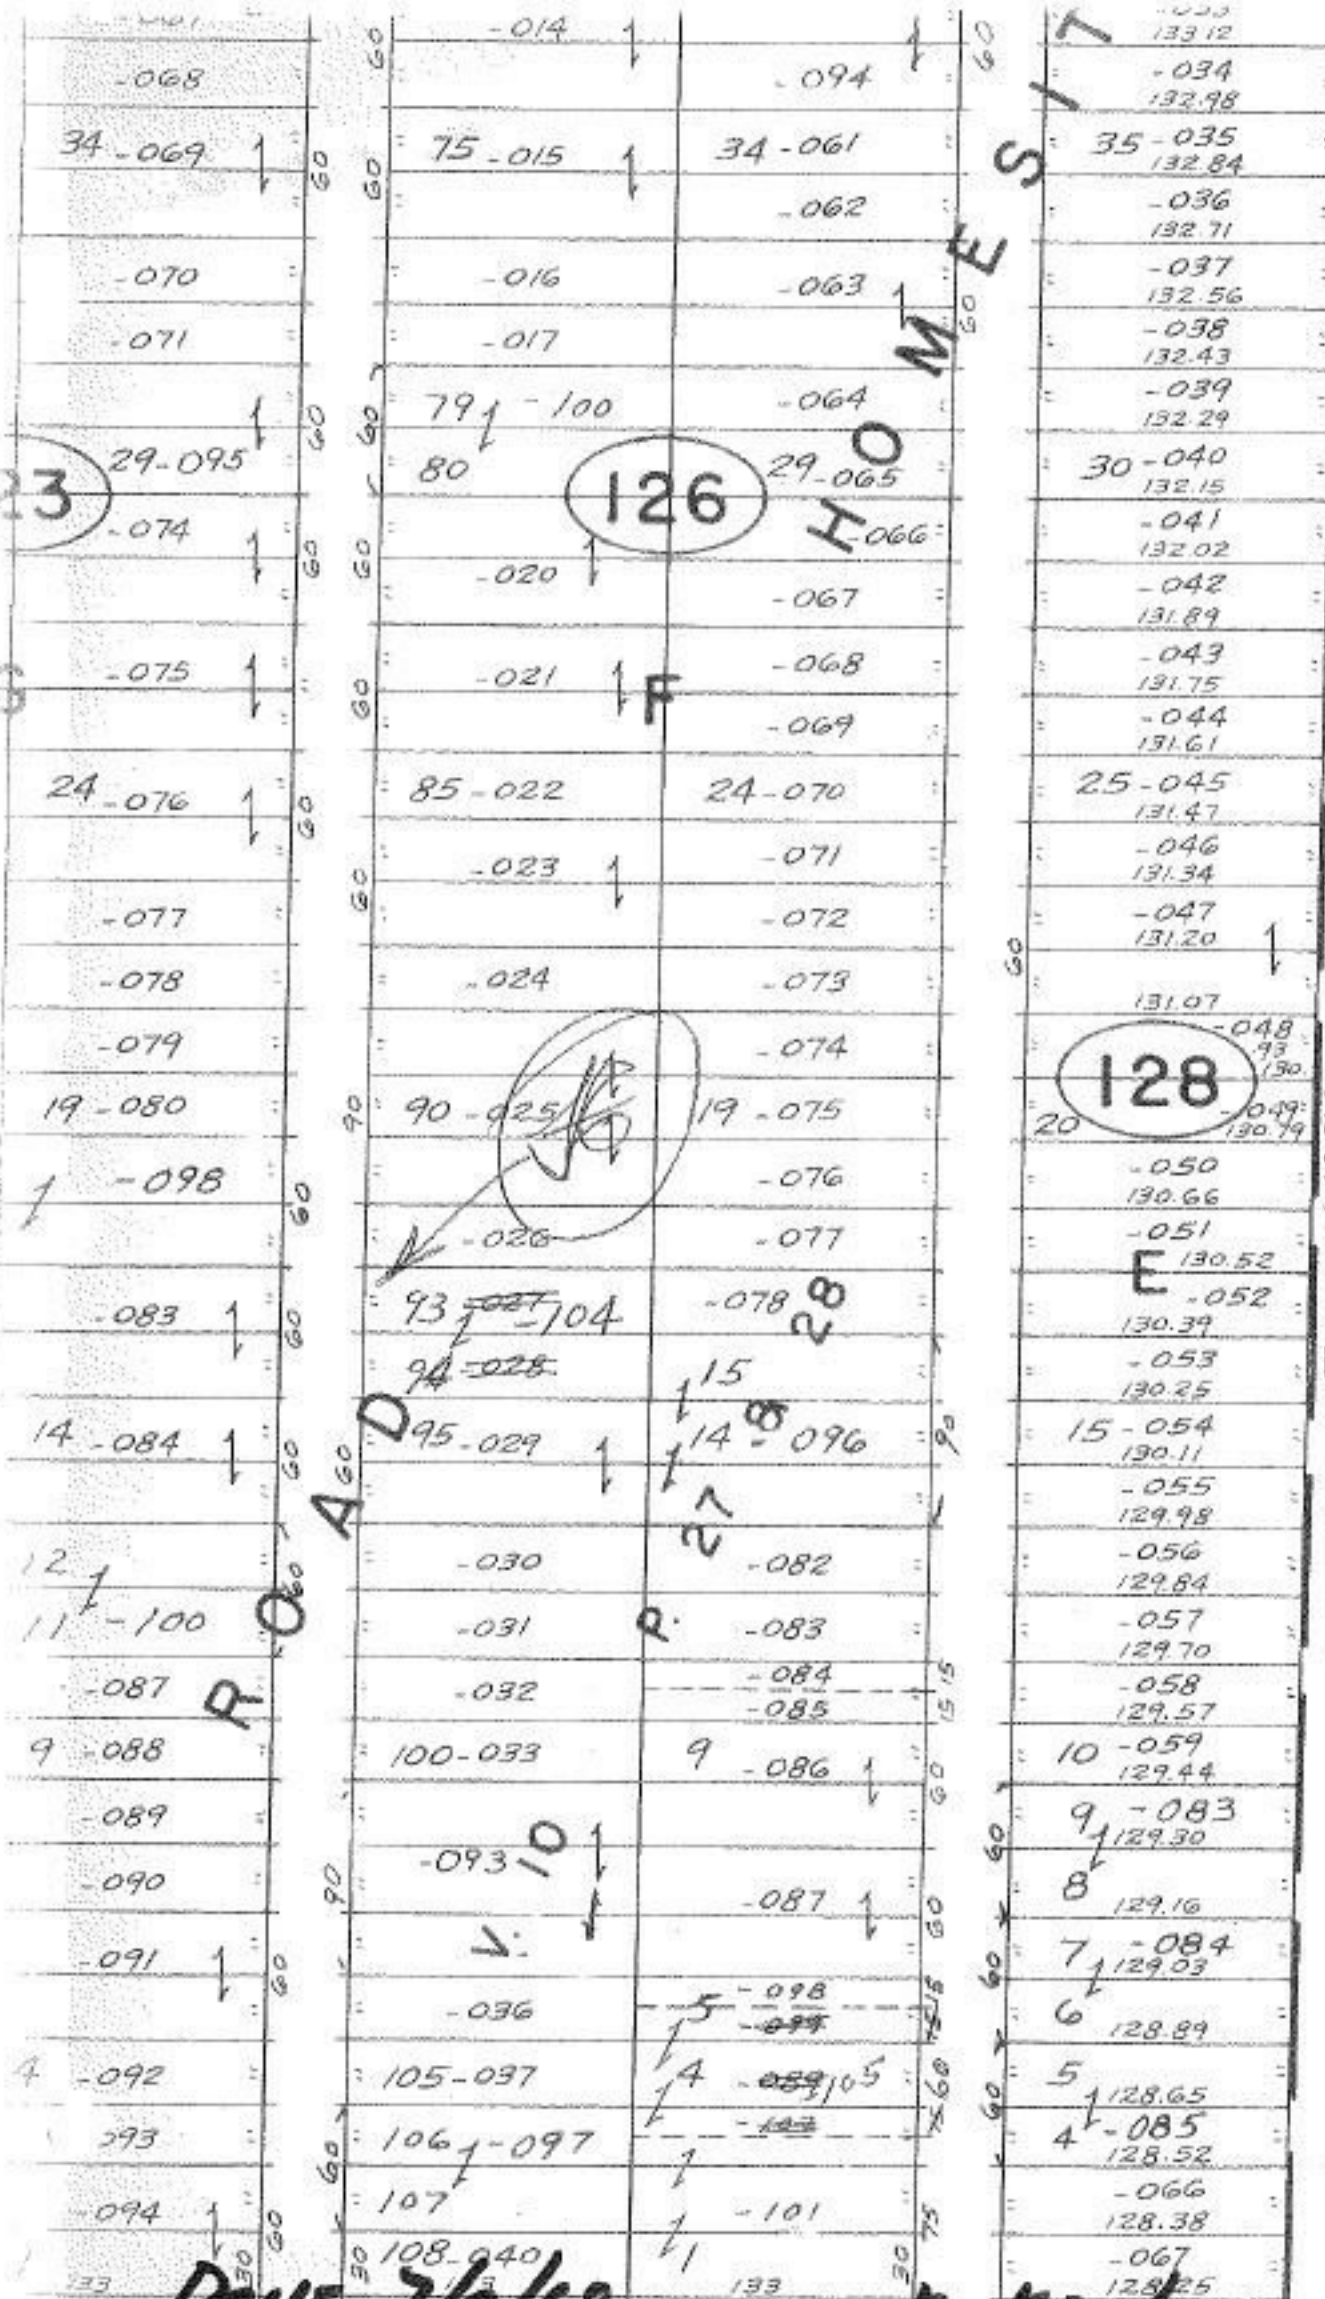

1734

APPROVED
LORAIN CO.
MAP DEPT.
5-3-68
DATE 3-5-68
7-00-017-D
BY
Stollert

7-15-86 8MB

DONE 7/6/68

n. Koechie