


# Ac. CORR, PER DEED VOL. 1375/ 785

SEE 1-

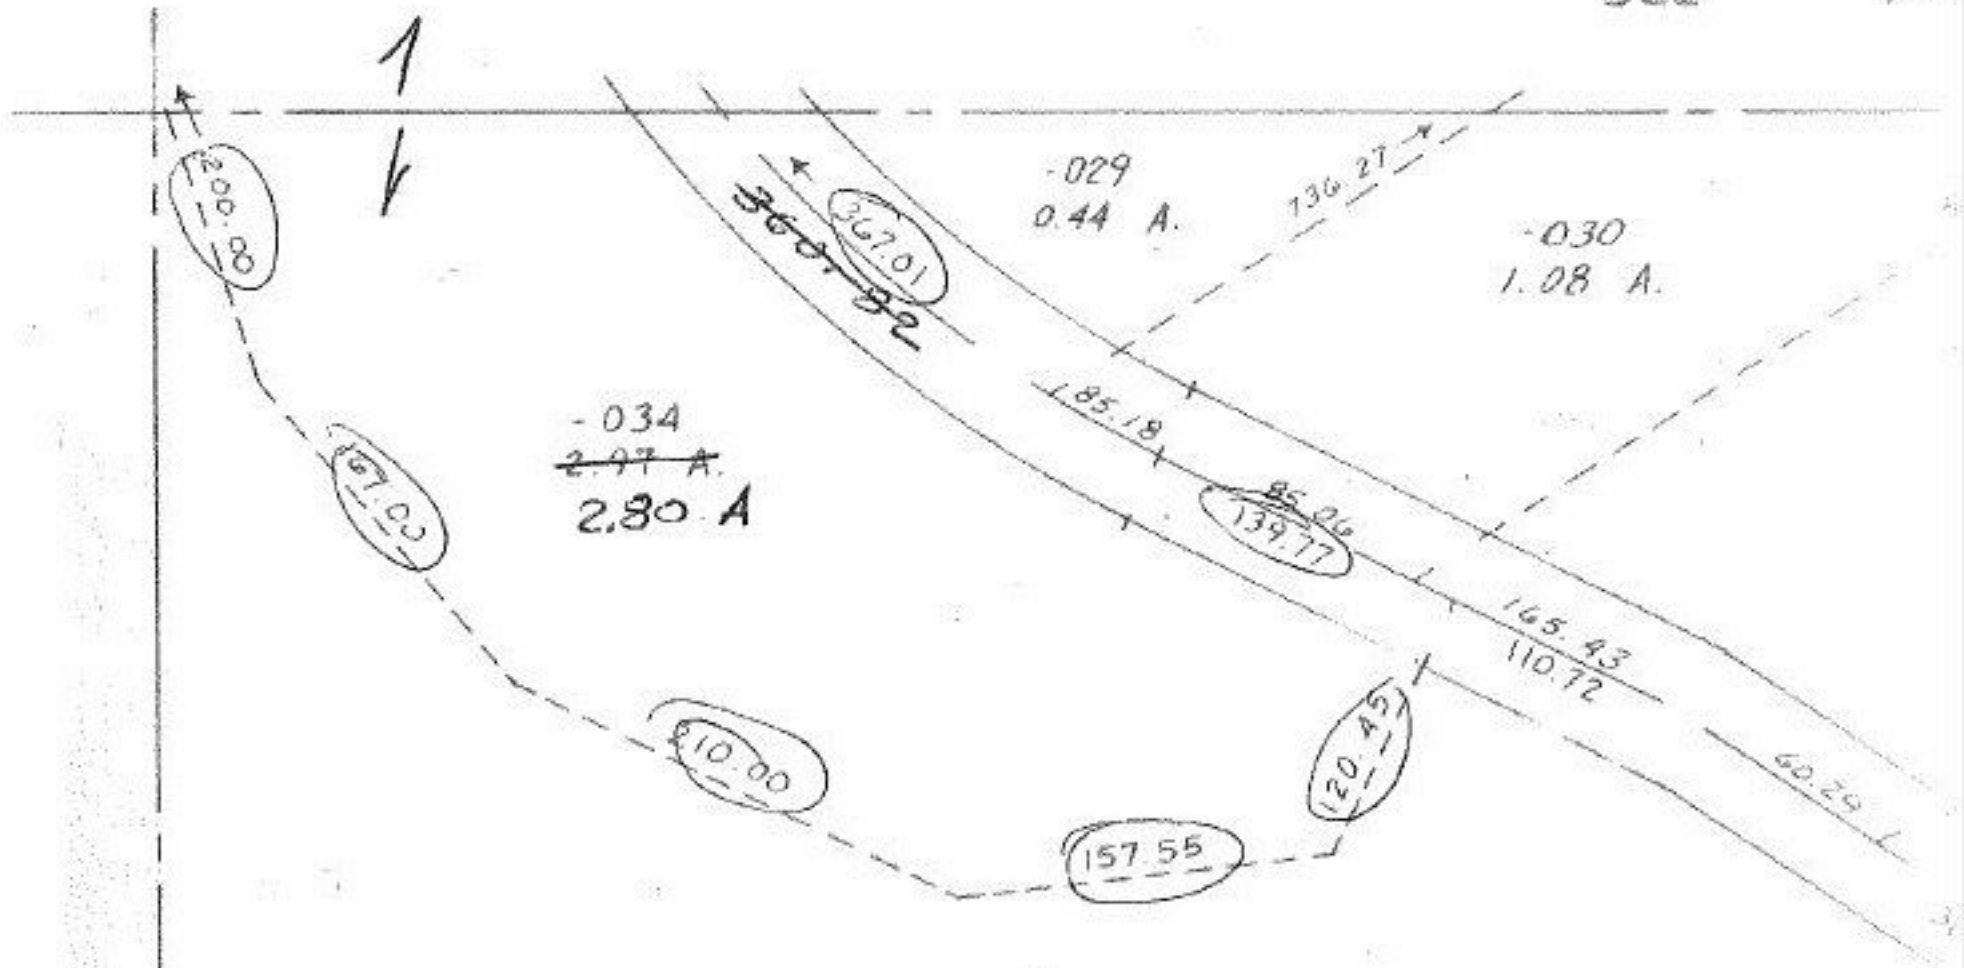

4-29-87  
#17345

APPROVED	
LORAIN CO.	
MAP DEPT.	
DATE	3-24-87
PAGE	1-00-046-A
BY	C. FRANCIS
VOID AFTER	17345

$-033$   
 $14.28$  A.