


1737
 11-30-87 *EF*
 20
 35

SEE 4-G

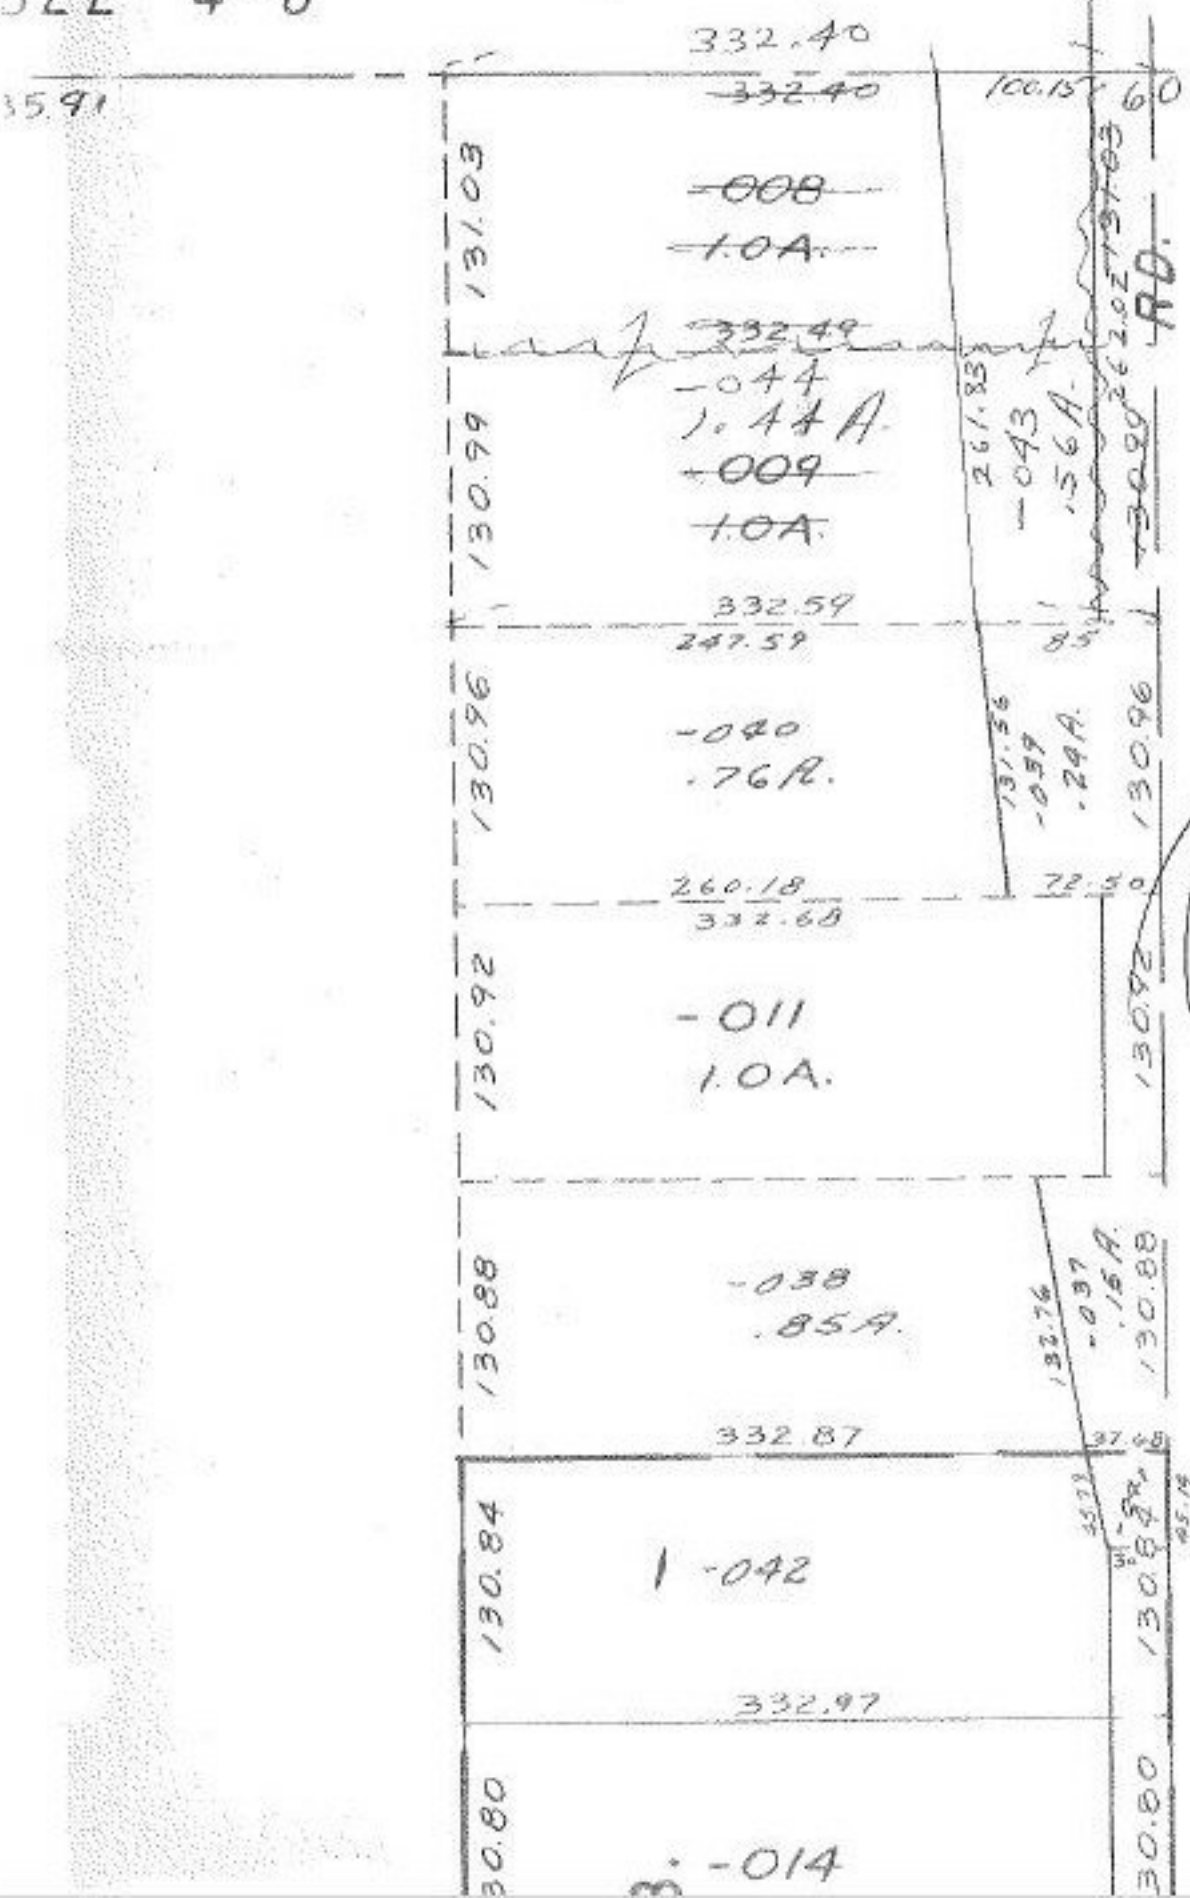

#1737
APPROVED
LORAIN CO.
MAP DEPT.
 DATE 5-7-68
 5-79-04-00-022-B
 BY *N. Maynard*

DONE
 6-8-68
 LW Hall