


SL 50 1194/894

SL 49 940/479

SL 47/48 929/314

DV 1194/894

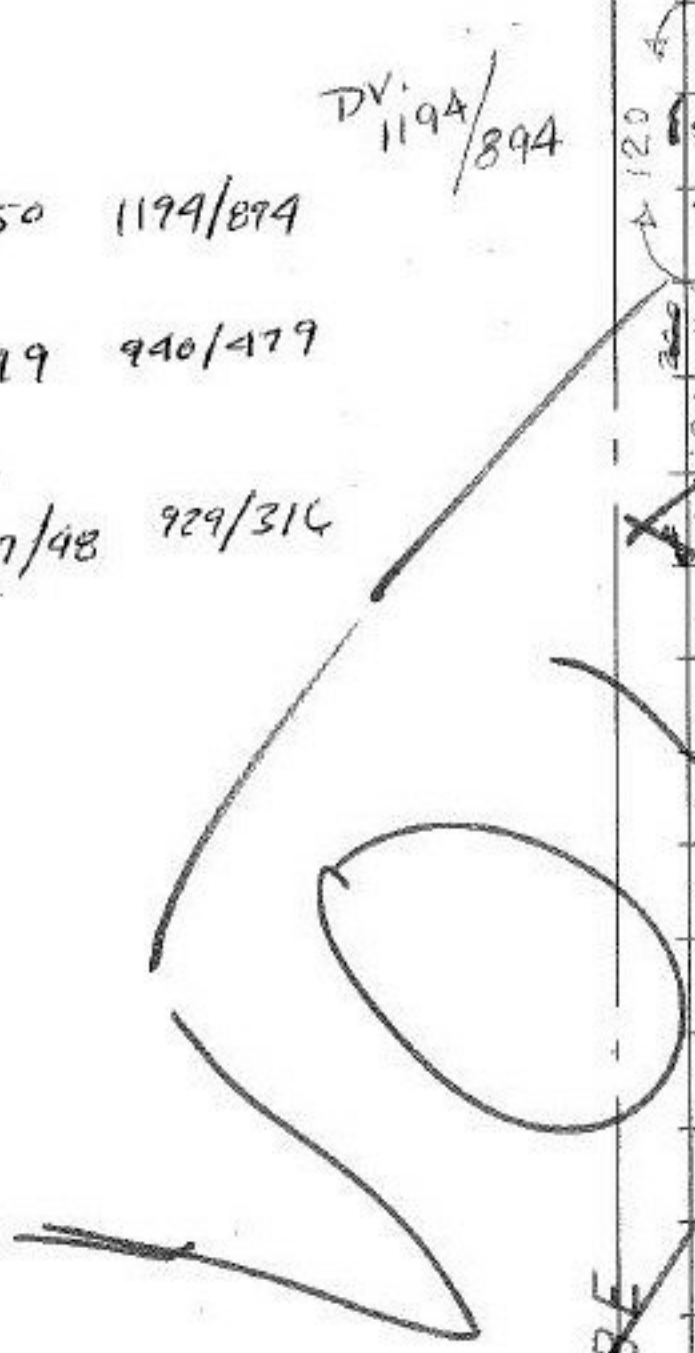

ABBE

PLEASANTVIEW

56-009	Z ¹¹ ₋₀₃₆	9-009	90.87
55-010	12-037	10-010	91.15
54-011	D ¹³ ₋₀₃₈	11-011	91.4
53	14-039	12-012	91.67
52-061	O ¹⁵ ₋₀₄₀	13-013	91.94
51	16-041	14-014	92.20
50-044	O ¹⁷ ₋₀₄₂	15-015	92.46
49-063	18-043	16-016	92.72
48	(107)	(108)	92.98
47-066	C ²⁰ ₋₀₄₅	18-018	93.24
46-064	F ²¹ ₋₀₄₆	19-019	93.51
45	22-047	20-020	93.77
44-020	W ²³ ₋₀₄₈	21-021	94.03
43-021	24-049	22-022	94.29
42-022	S ²⁵ ₋₀₅₀	23-023	94.55
41-023	26-051	24-024	94.81
40-024	Z ²⁷ ₋₀₅₂	25-025	95.07
39-025	28-053	26-026	95.34
38-026	D ²⁹ ₋₀₅₄	27-027	95.60
37-027	30-055	28-028	95.86
36-028	S ³¹ ₋₀₅₆	29-029	96.12
35-029	32-057	30-030	96.38
34-030	33-058	31-031	96.63

174 03-00-033-115-009
PA 8 24 A

VOID
4/24/87

17386

APPROVED
CORAIN CO.
MAP DEPT.

DATE	4-22-87
PAGE	3-00-033A
BY	C. FRANCIS
VOID AFTER	17386

SPLIT NOT NECESSARY AS
COMB WAS UN-DONE & PARCELS
WAS STRAIGHT TRANSFERRED.

WALKER

1194/894 03-00-033-107-
PRIOR DEED 929-310
SL 48, 49, (50)