


RD. 2

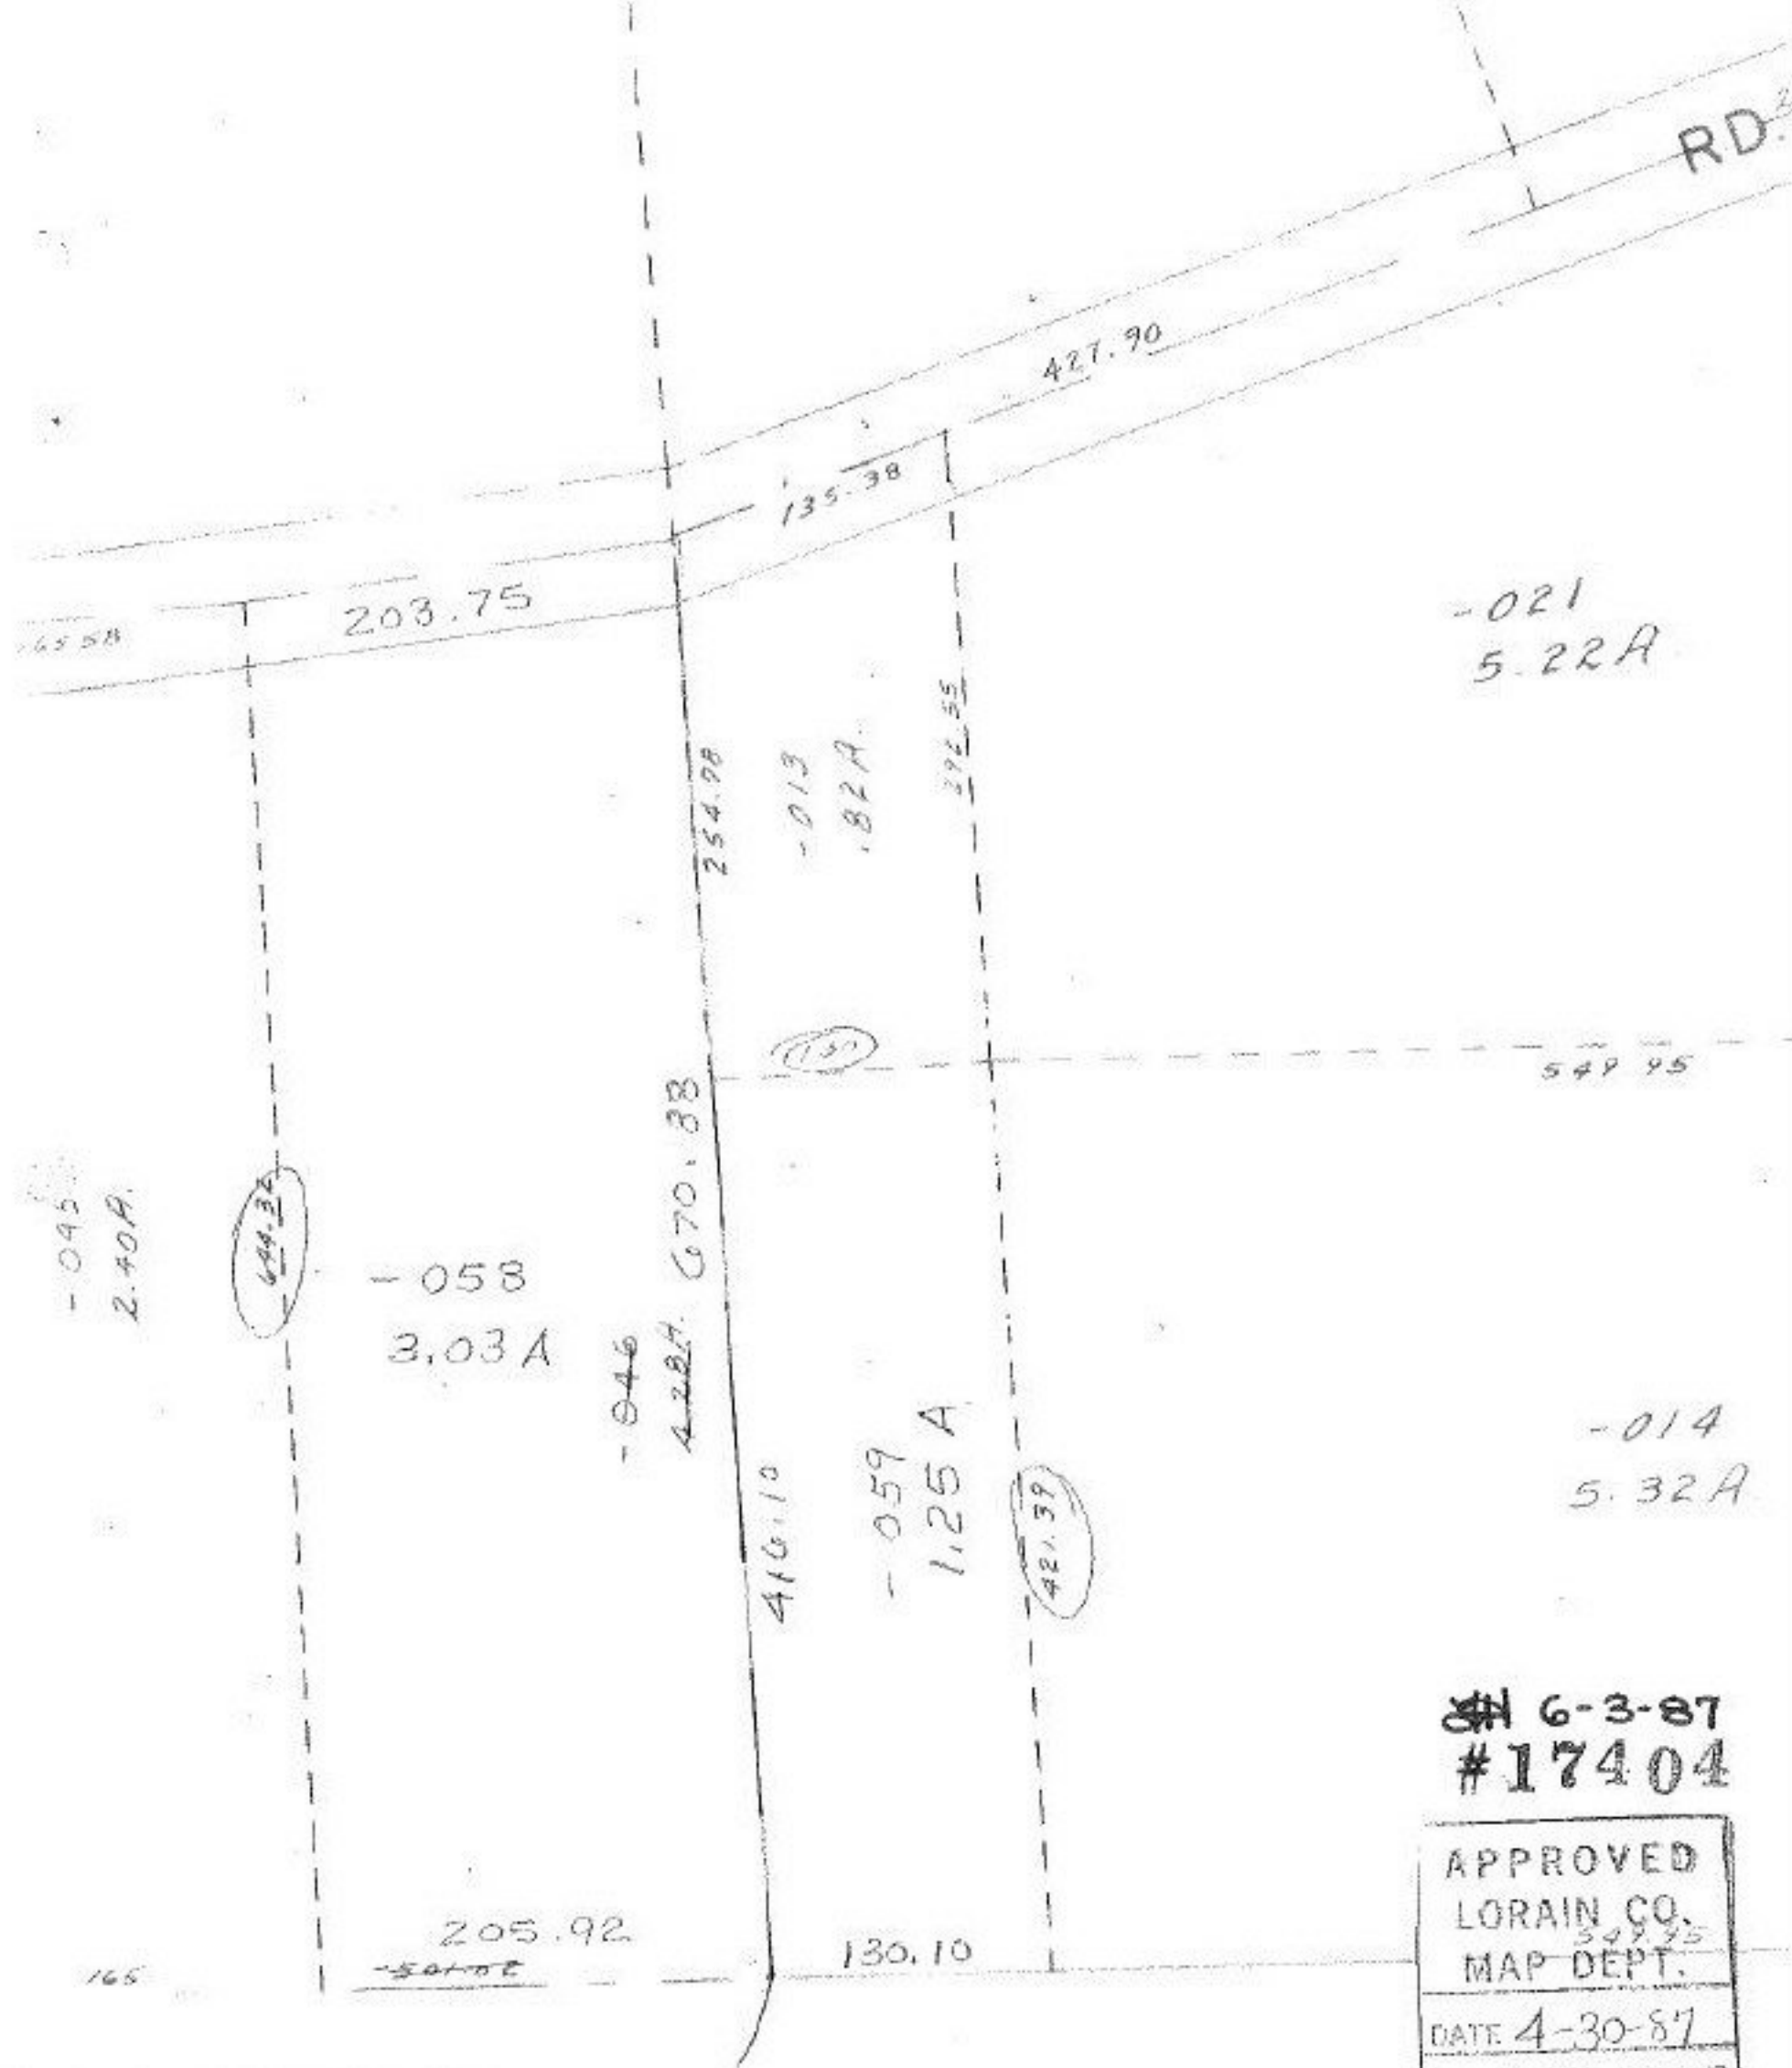

E. 1-00-038-B

1-00-027-000

(D) PRIOR DEED 840-580

6-3-87  
#17404

APPROVED	
LORAIN CO.	
MAP DEPT.	
DATE 4-30-87	
PAGE 1-00-027 B	
BY C. FRANCIS	
VOID AFTER	17404