


RIDGEVILLE - LORAIN

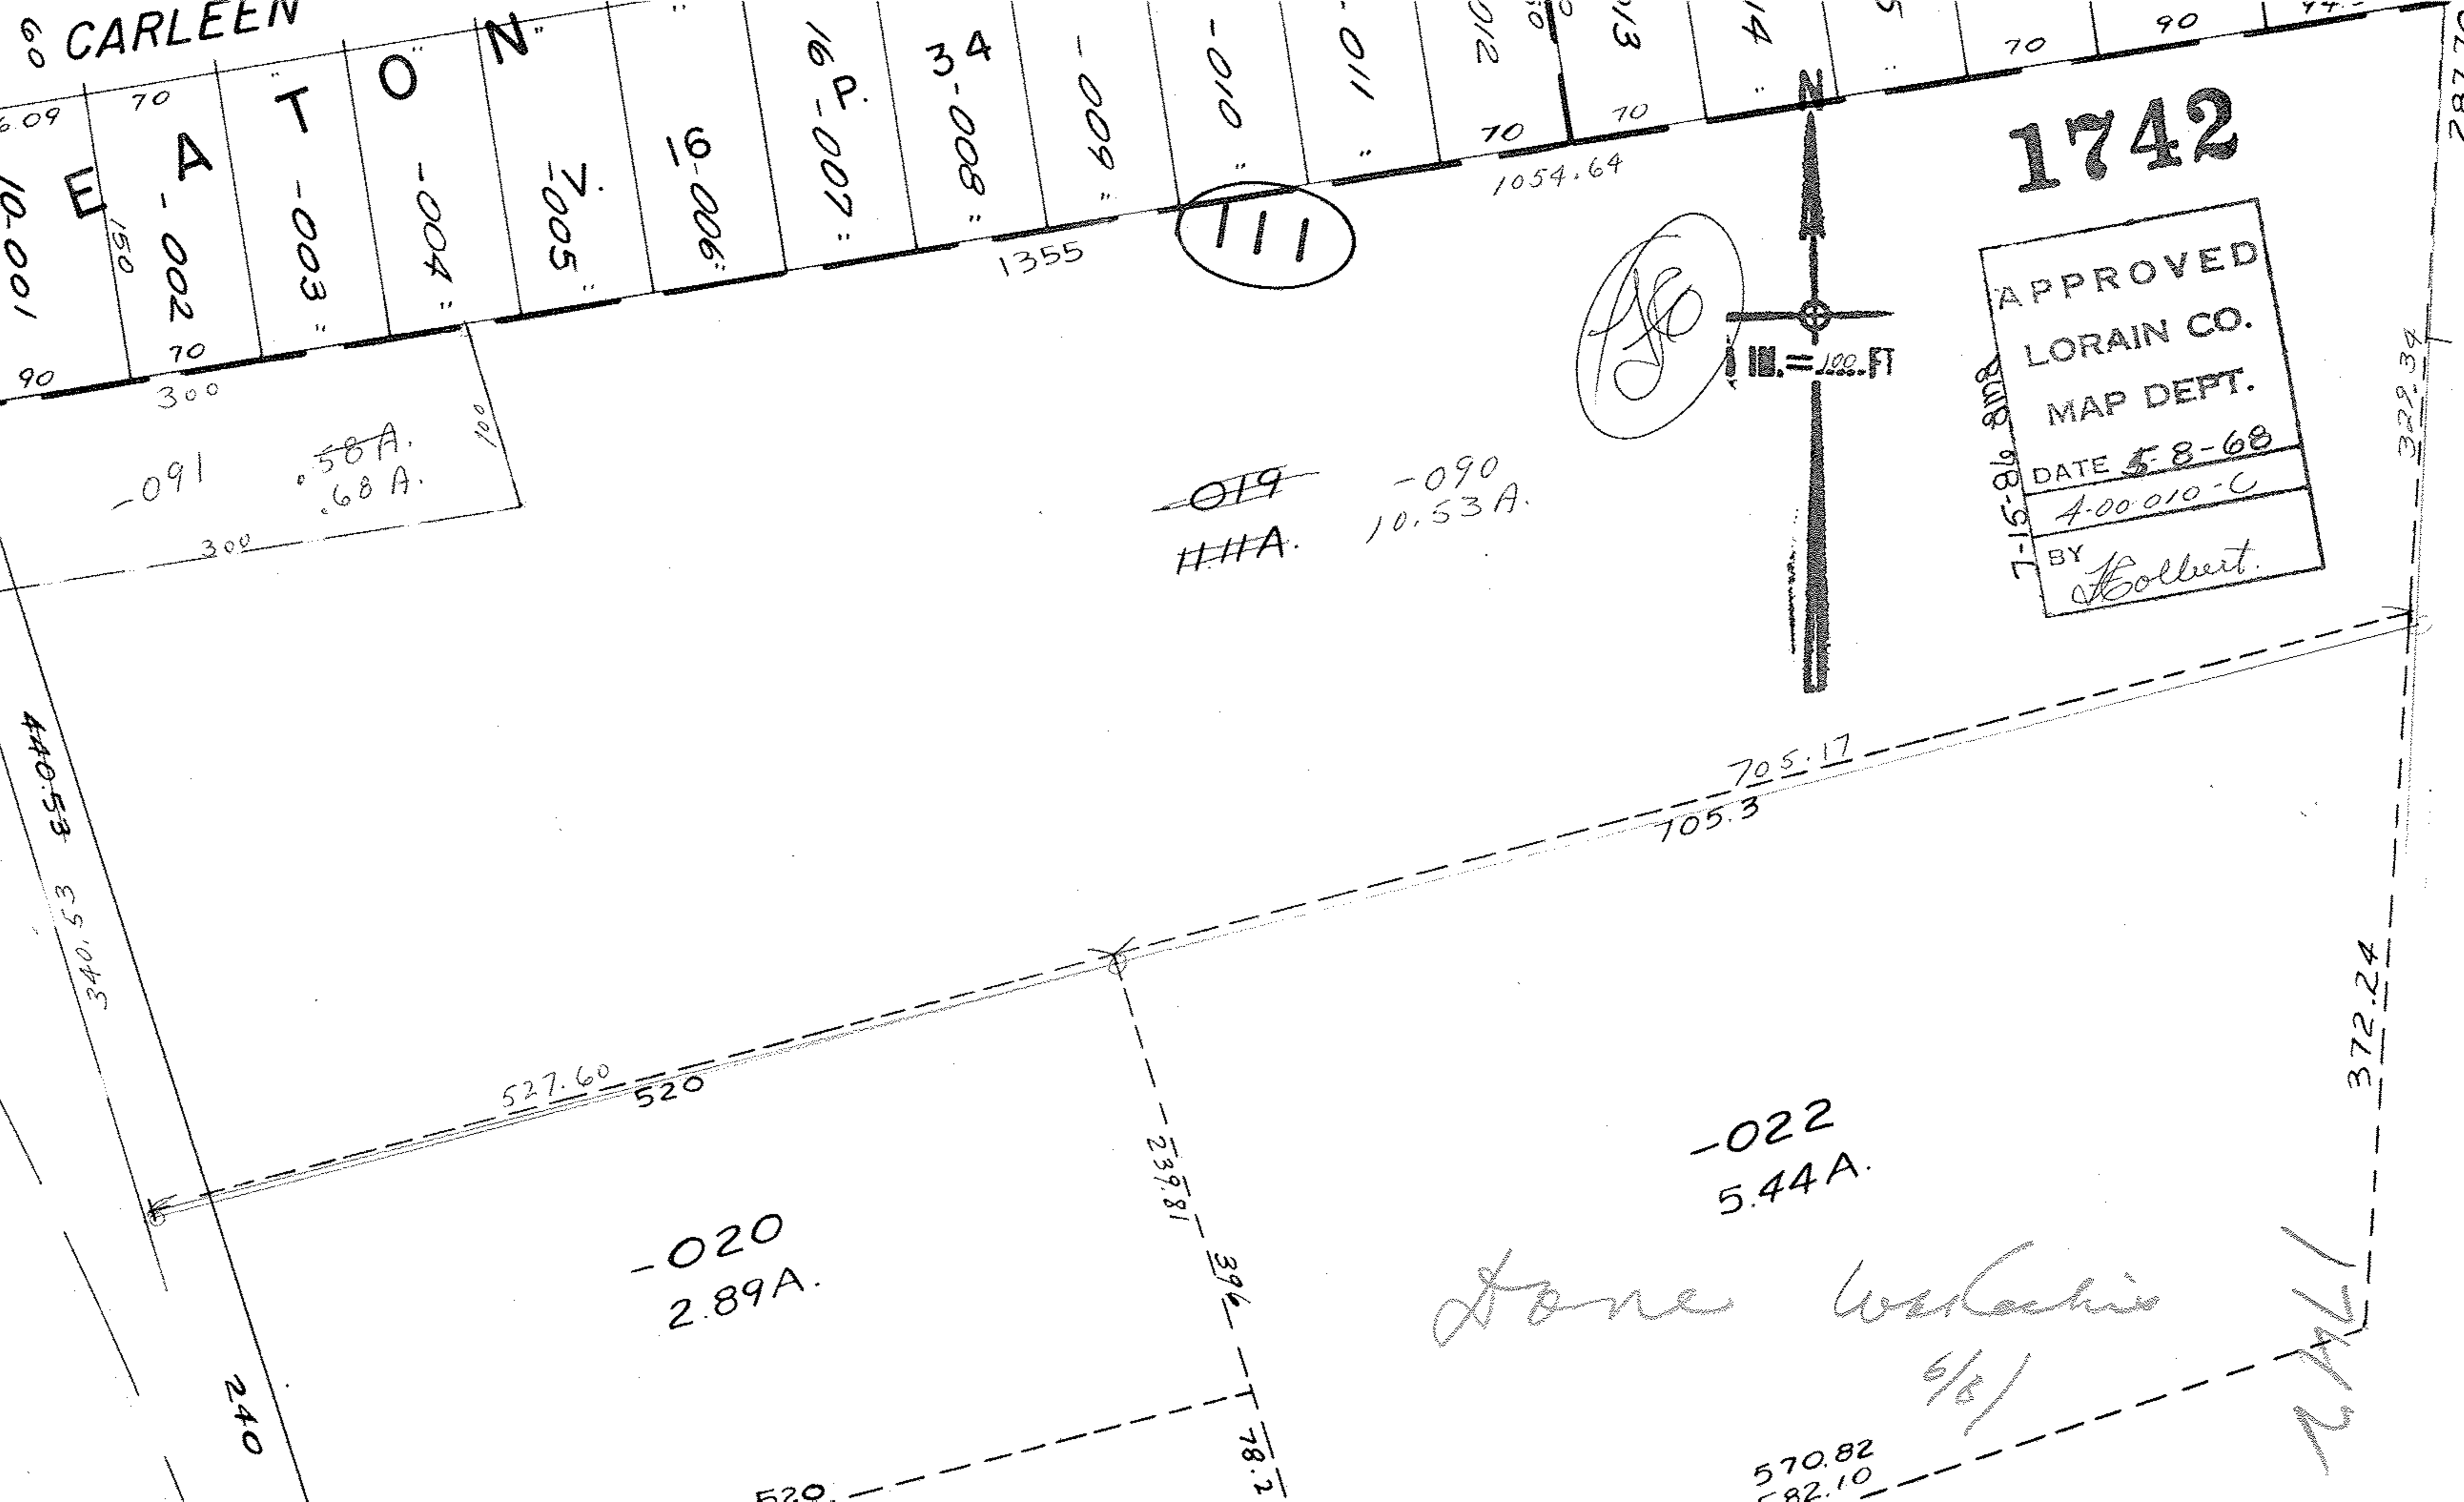

1742

APPROVED
LORAIN CO.
MAP DEPT.
DATE 5-8-68
4-00-010-C
BY *Robert*

-022
5.44 A.

Stone w/achio
5/10

-020
2.89 A.

~~019~~
11.11 A. 10.53 A.

-091
58 A.
68 A.

440.53
340.53

R-30
51.19
152.20
117.02

76.09
10-001
150
70
90
300

A-002
70
300

T-003
70
300

O-004
70
300

Z-005
70
300

9-006
70
300

16-007
70
300

5-008
70
300

6-009
70
300

0-010
70
300

0-011
70
300

0-012
70
300

0-013
70
300

0-014
70
300

70
300

90
300

1054.64

152.20
117.02

150
70
90
300

150
70
90
300

152.20
117.02

150
70
90
300

150
70
90
300

152.20
117.02

150
70
90
300

150
70
90
300

152.20
117.02

150
70
90
300

150
70
90
300

