


SSIA TWP.

" = 400'

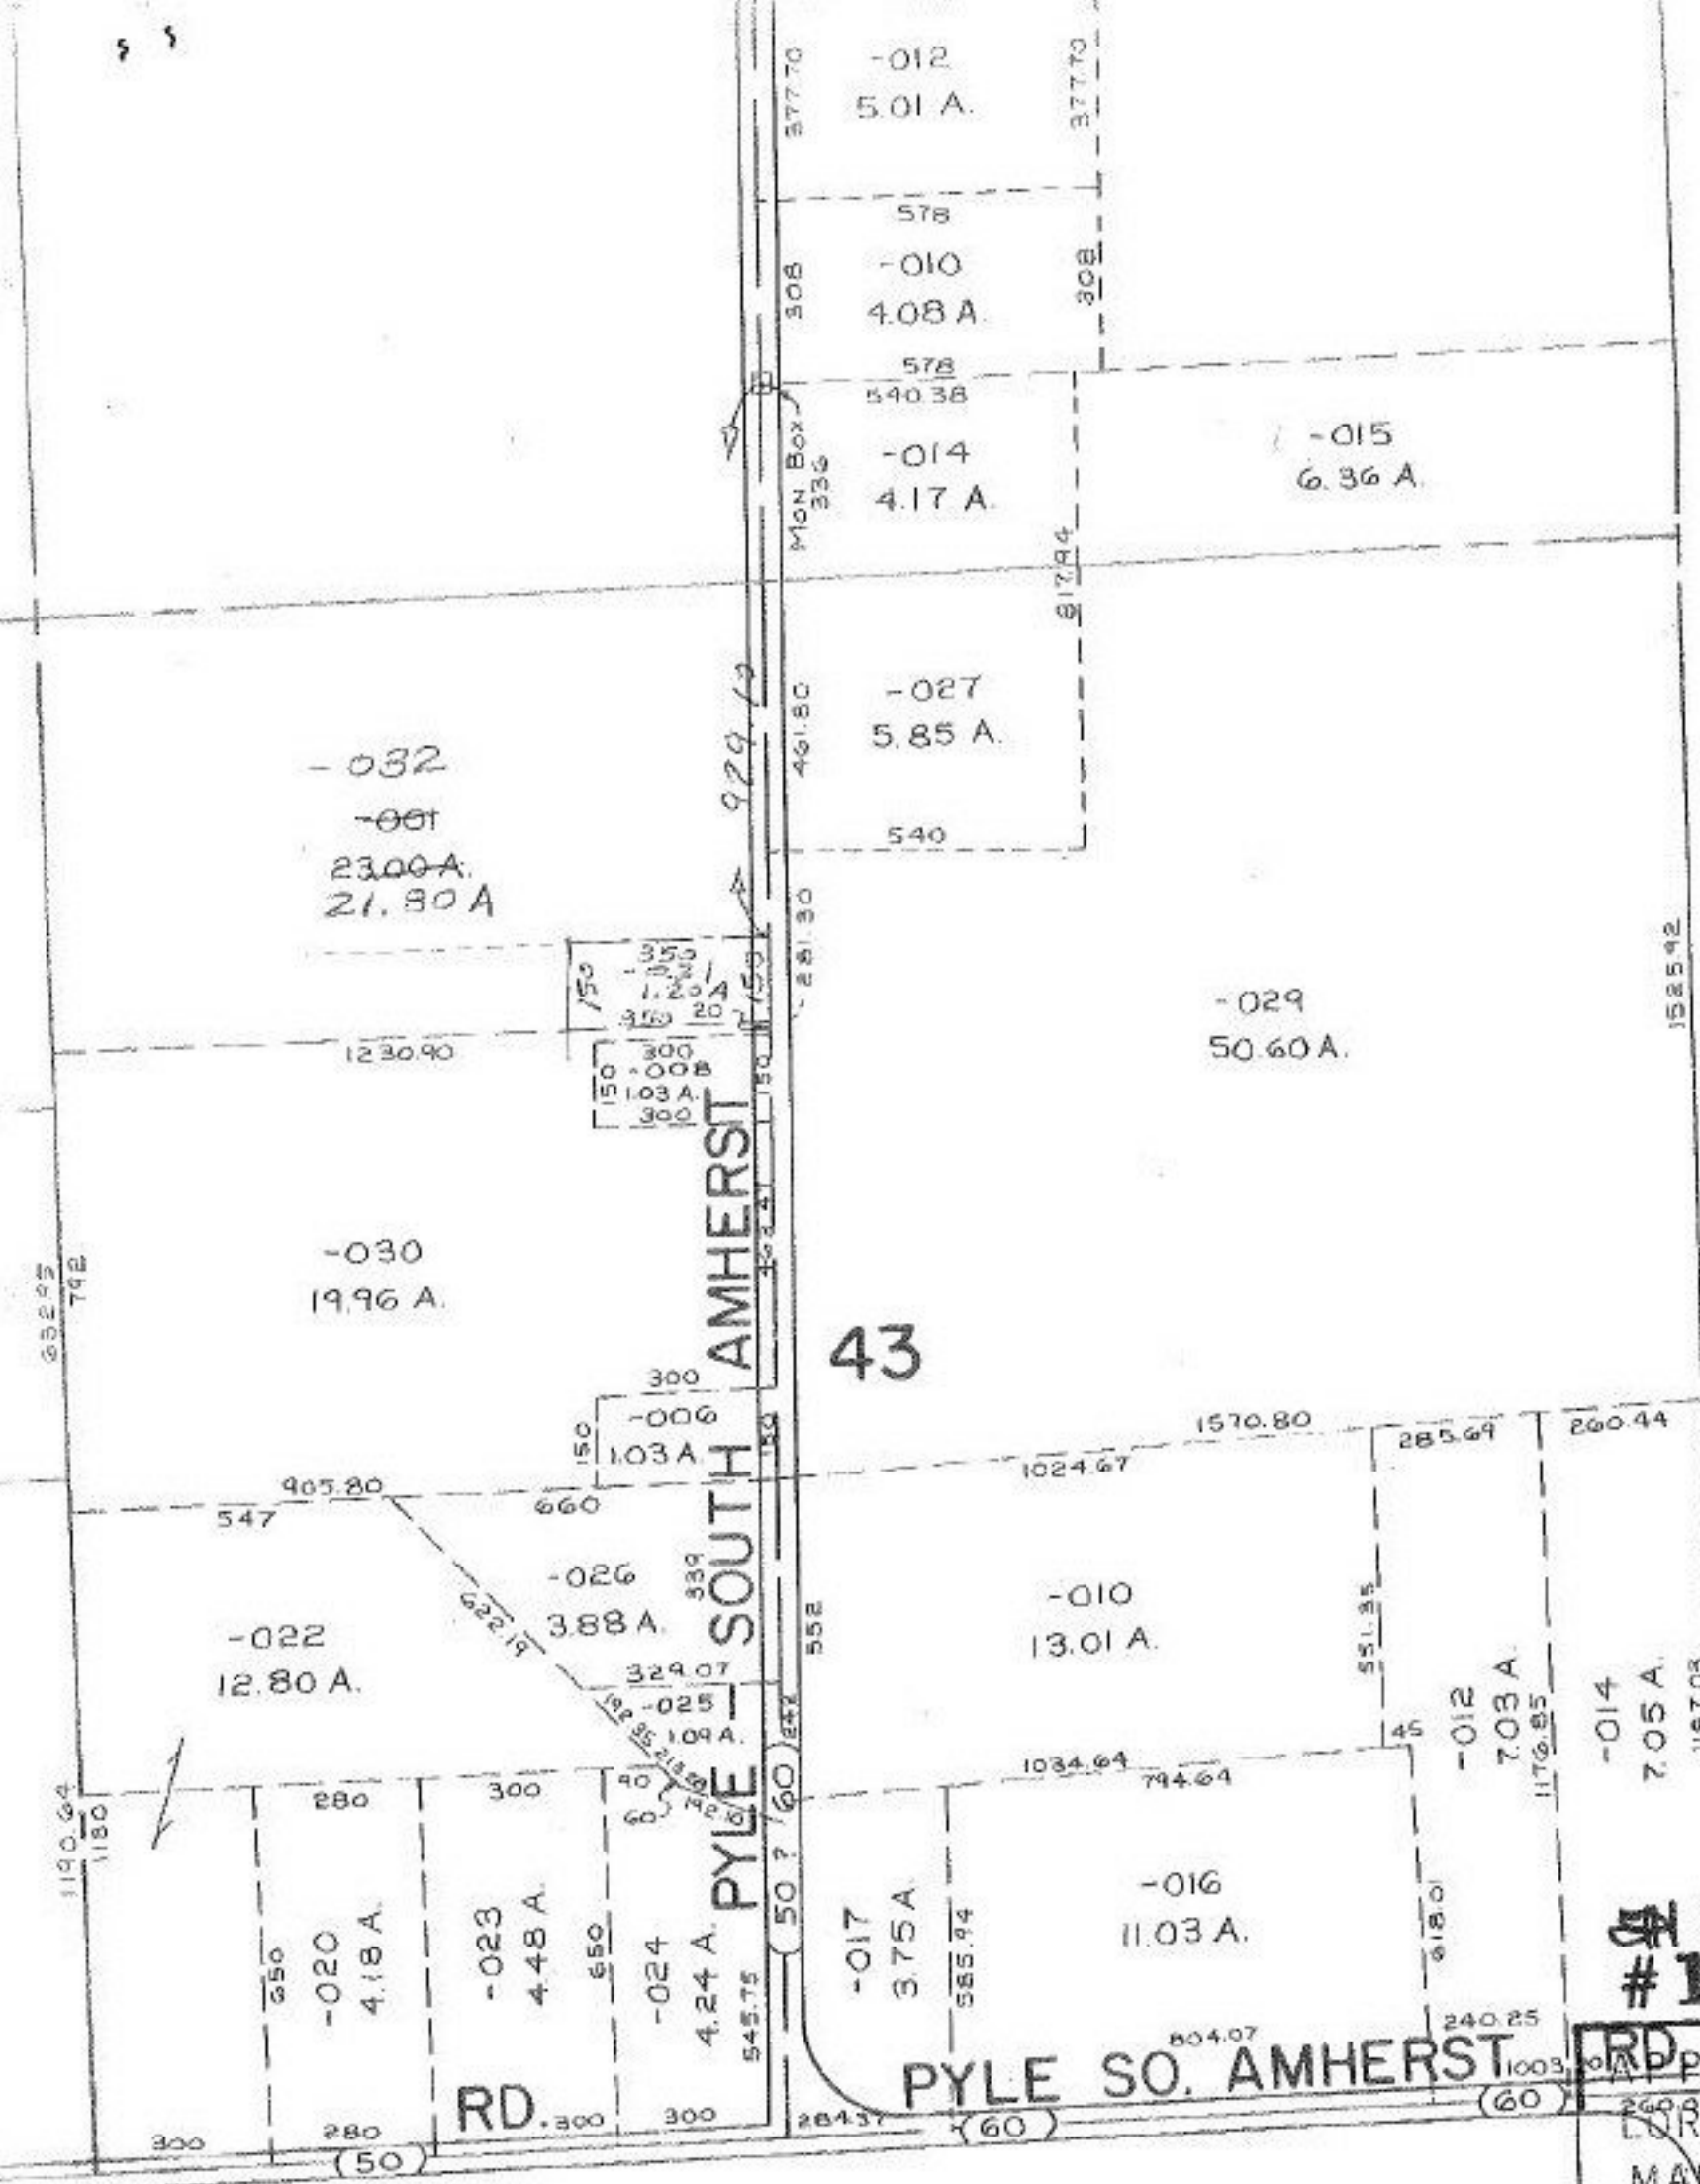

43

6-18-87
#17440

APPROVED
DRAIN CO.
MAP DEPT.

DATE 5-27-87
PAGE 9-A
BY C. FRANCIS
VOID AFTER 17440

09-00-043-000
Prior Dec'd 1098-876
Survey By Arnold Koepf
Reg. Surveyor