


SEE 9-00-085-B

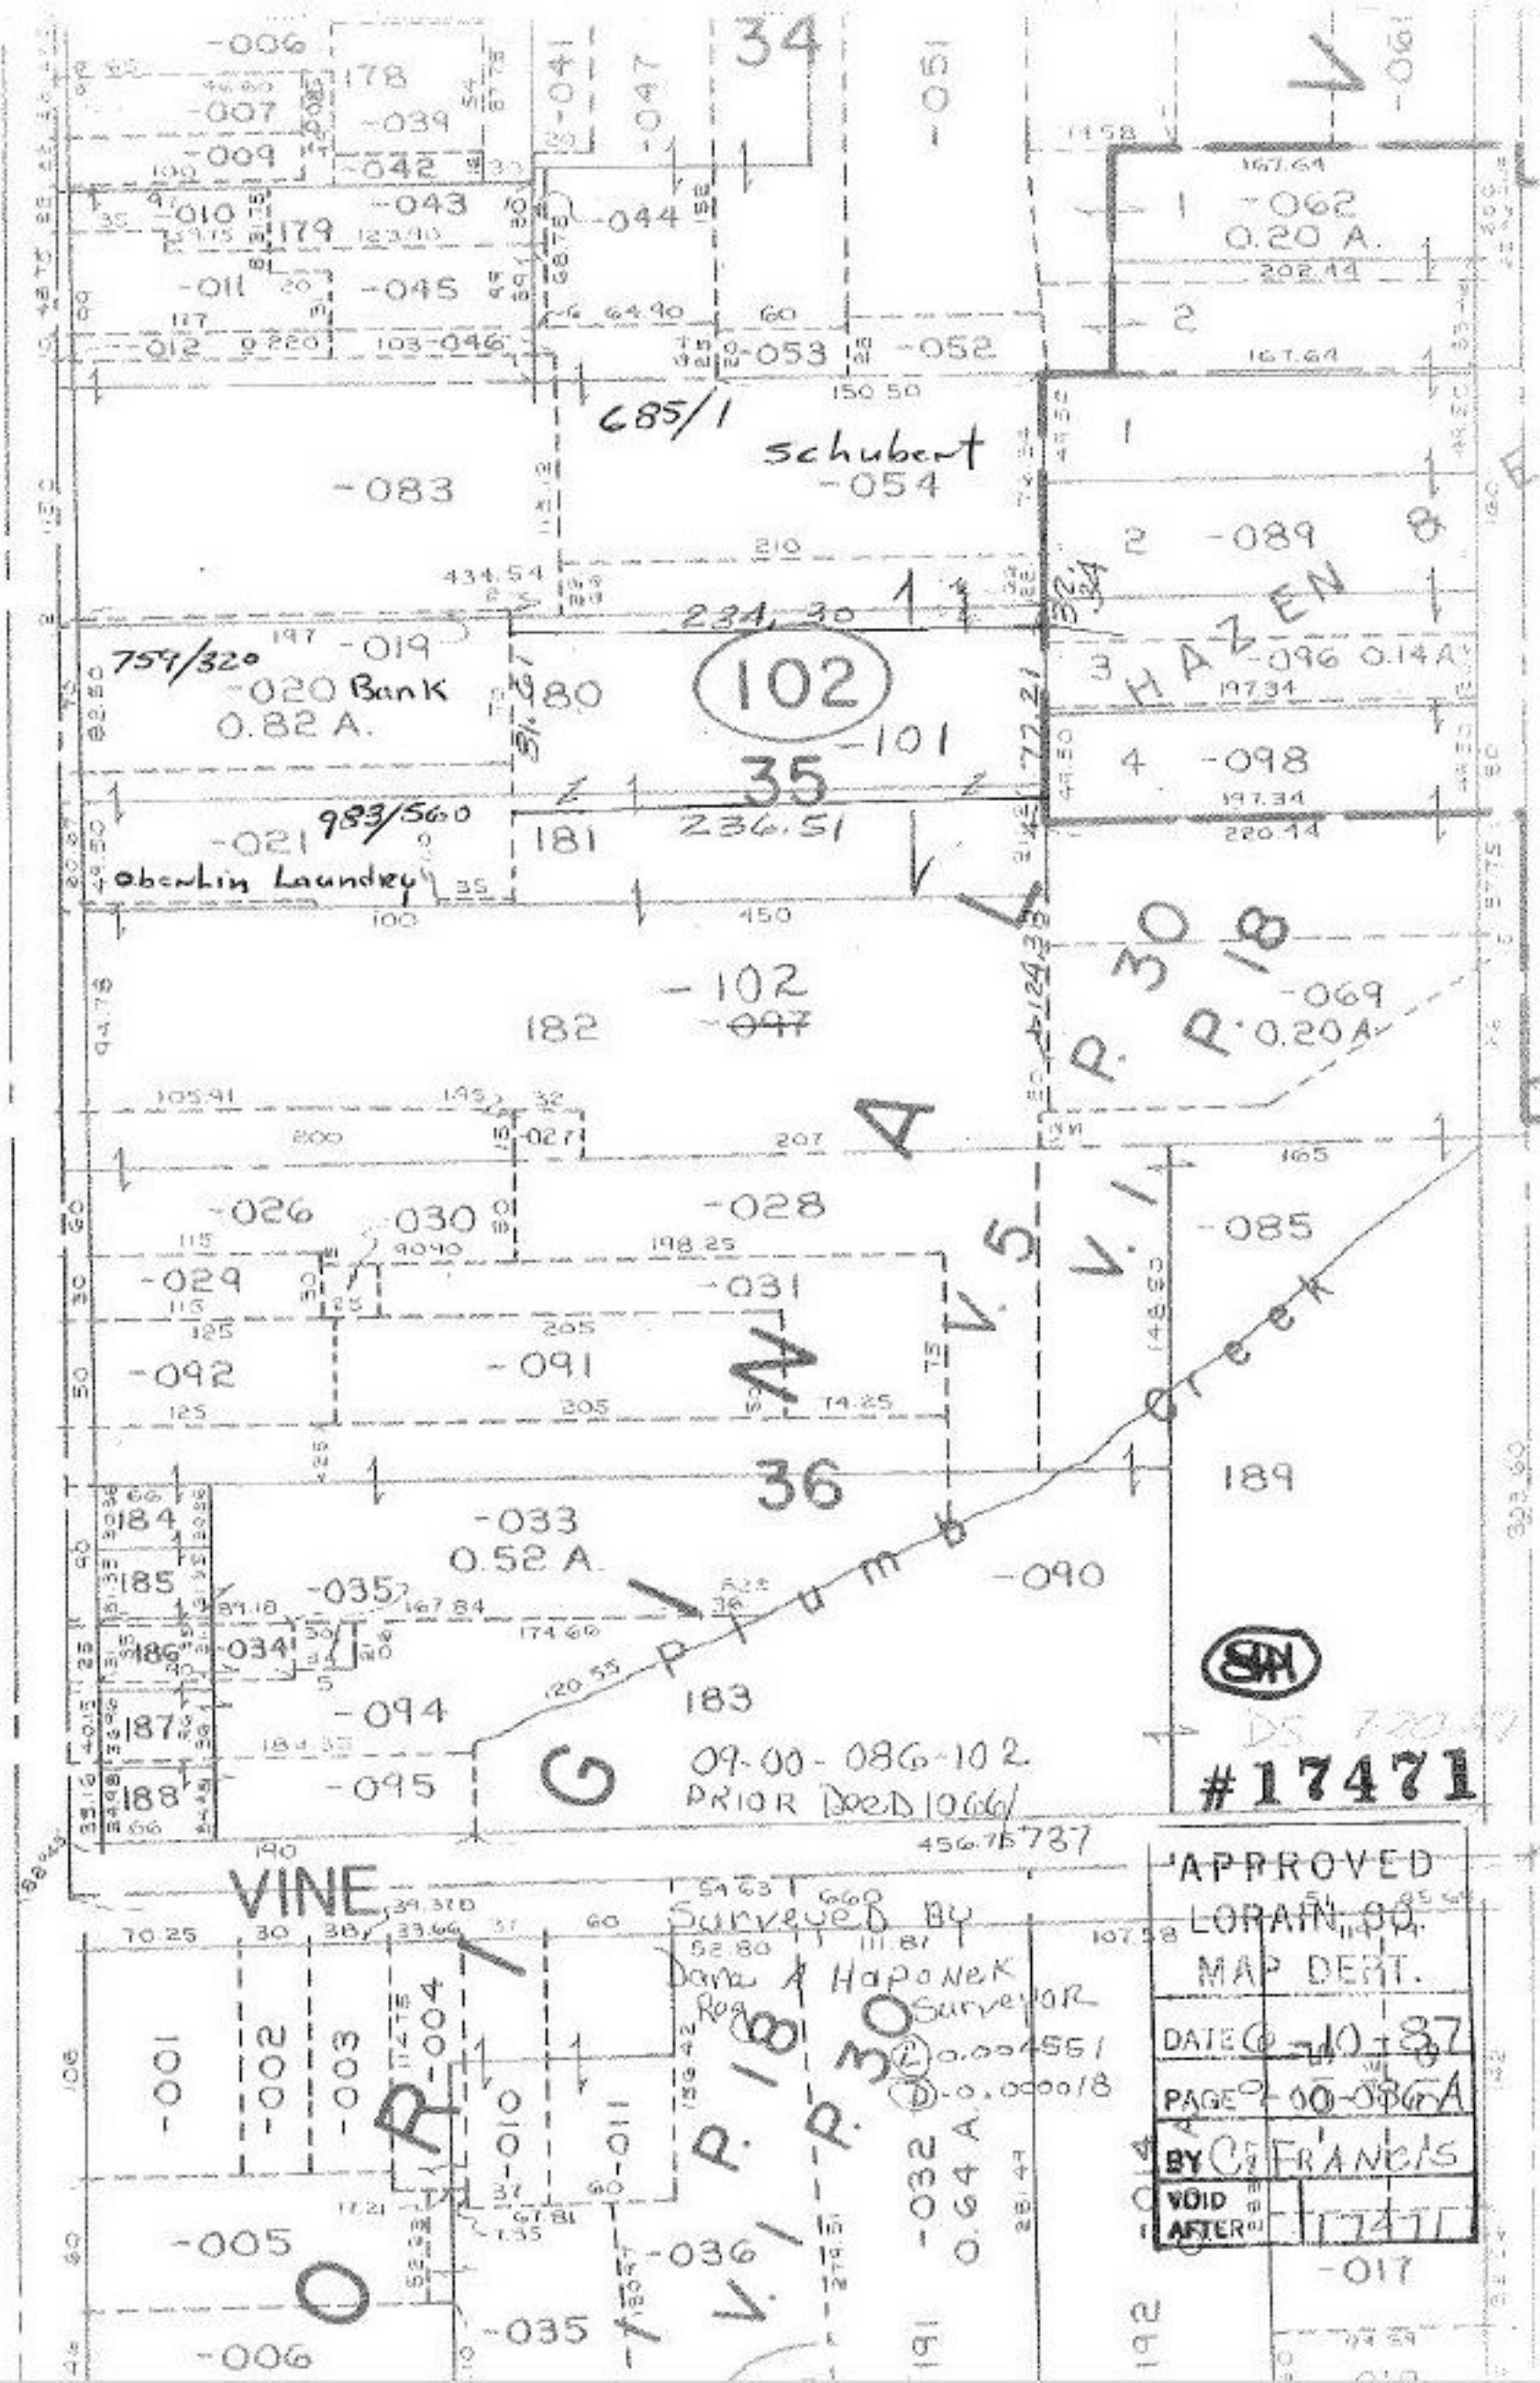

685/1 Schubert -054

102

HAZEN

759/320 -019 Bank 0.82 A

983/560 -021 Oberlin Laundry

P. 30 P. 18 -069 0.20 A

182 -102 -097

A

V. 5 V. 1 Creek

183 -033 0.52 A

G 09-00-086-102 PRIOR Doc. 1066/



DS 720-47 #17471

VINE

Surveyed BY Dan A Haponek Reg. Surveyor

APPROVED LORAIN CO. MAP DEPT.

DATE 10-1-37

PAGE 00-086A

BY C. FRANK'S

VOID AFTER 17471

R-004

P. 18 P. 30

O

-032 0.64 A

192

-017