

-005
91.00 A.
41

T


C

-004
3.00 A.

-002
43.59 A.

40

-00
116

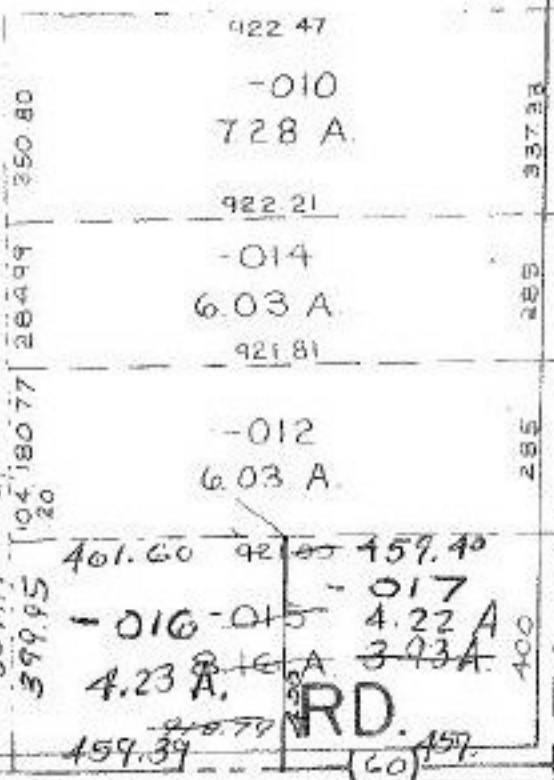


Ac. Corr. Rec
Survey By
W. B. Barton
Reg. Surveyor
C=1: INF

SHORT

44
-006
55.00 A.

19-06-040-000
PRIOR Deed 1145-624
Surveyed By W. B. Barton
Reg. Surveyor
C=1:166666

1374.87

 S. COUGHLIN
#17486

APPROVED
DRAIN CO.
MAP DEPT.

DATE 6-17-87
PAGE 19 of 21
BY C. FRANCIS

VOID
AFTER 17486

368.47
-002
200 A.
283.11

217.80
-004
81.50 A.

19-05-039-000-
-003
4.24 A.

210.06
617.35
-001
3.00 A.
227.55
435.60
-005
2.00 A.
200
435.60

542.60

-009
9.61 A.

470.78
-005
1.90 A.
180
283.24

501.45
-008
2.35 A.
504.17

401.60
-016
4.23 A.
159.39

RD.
CO.

114285

589
573

88°00'

559.58