




SEE 9-00-076

LORAIN

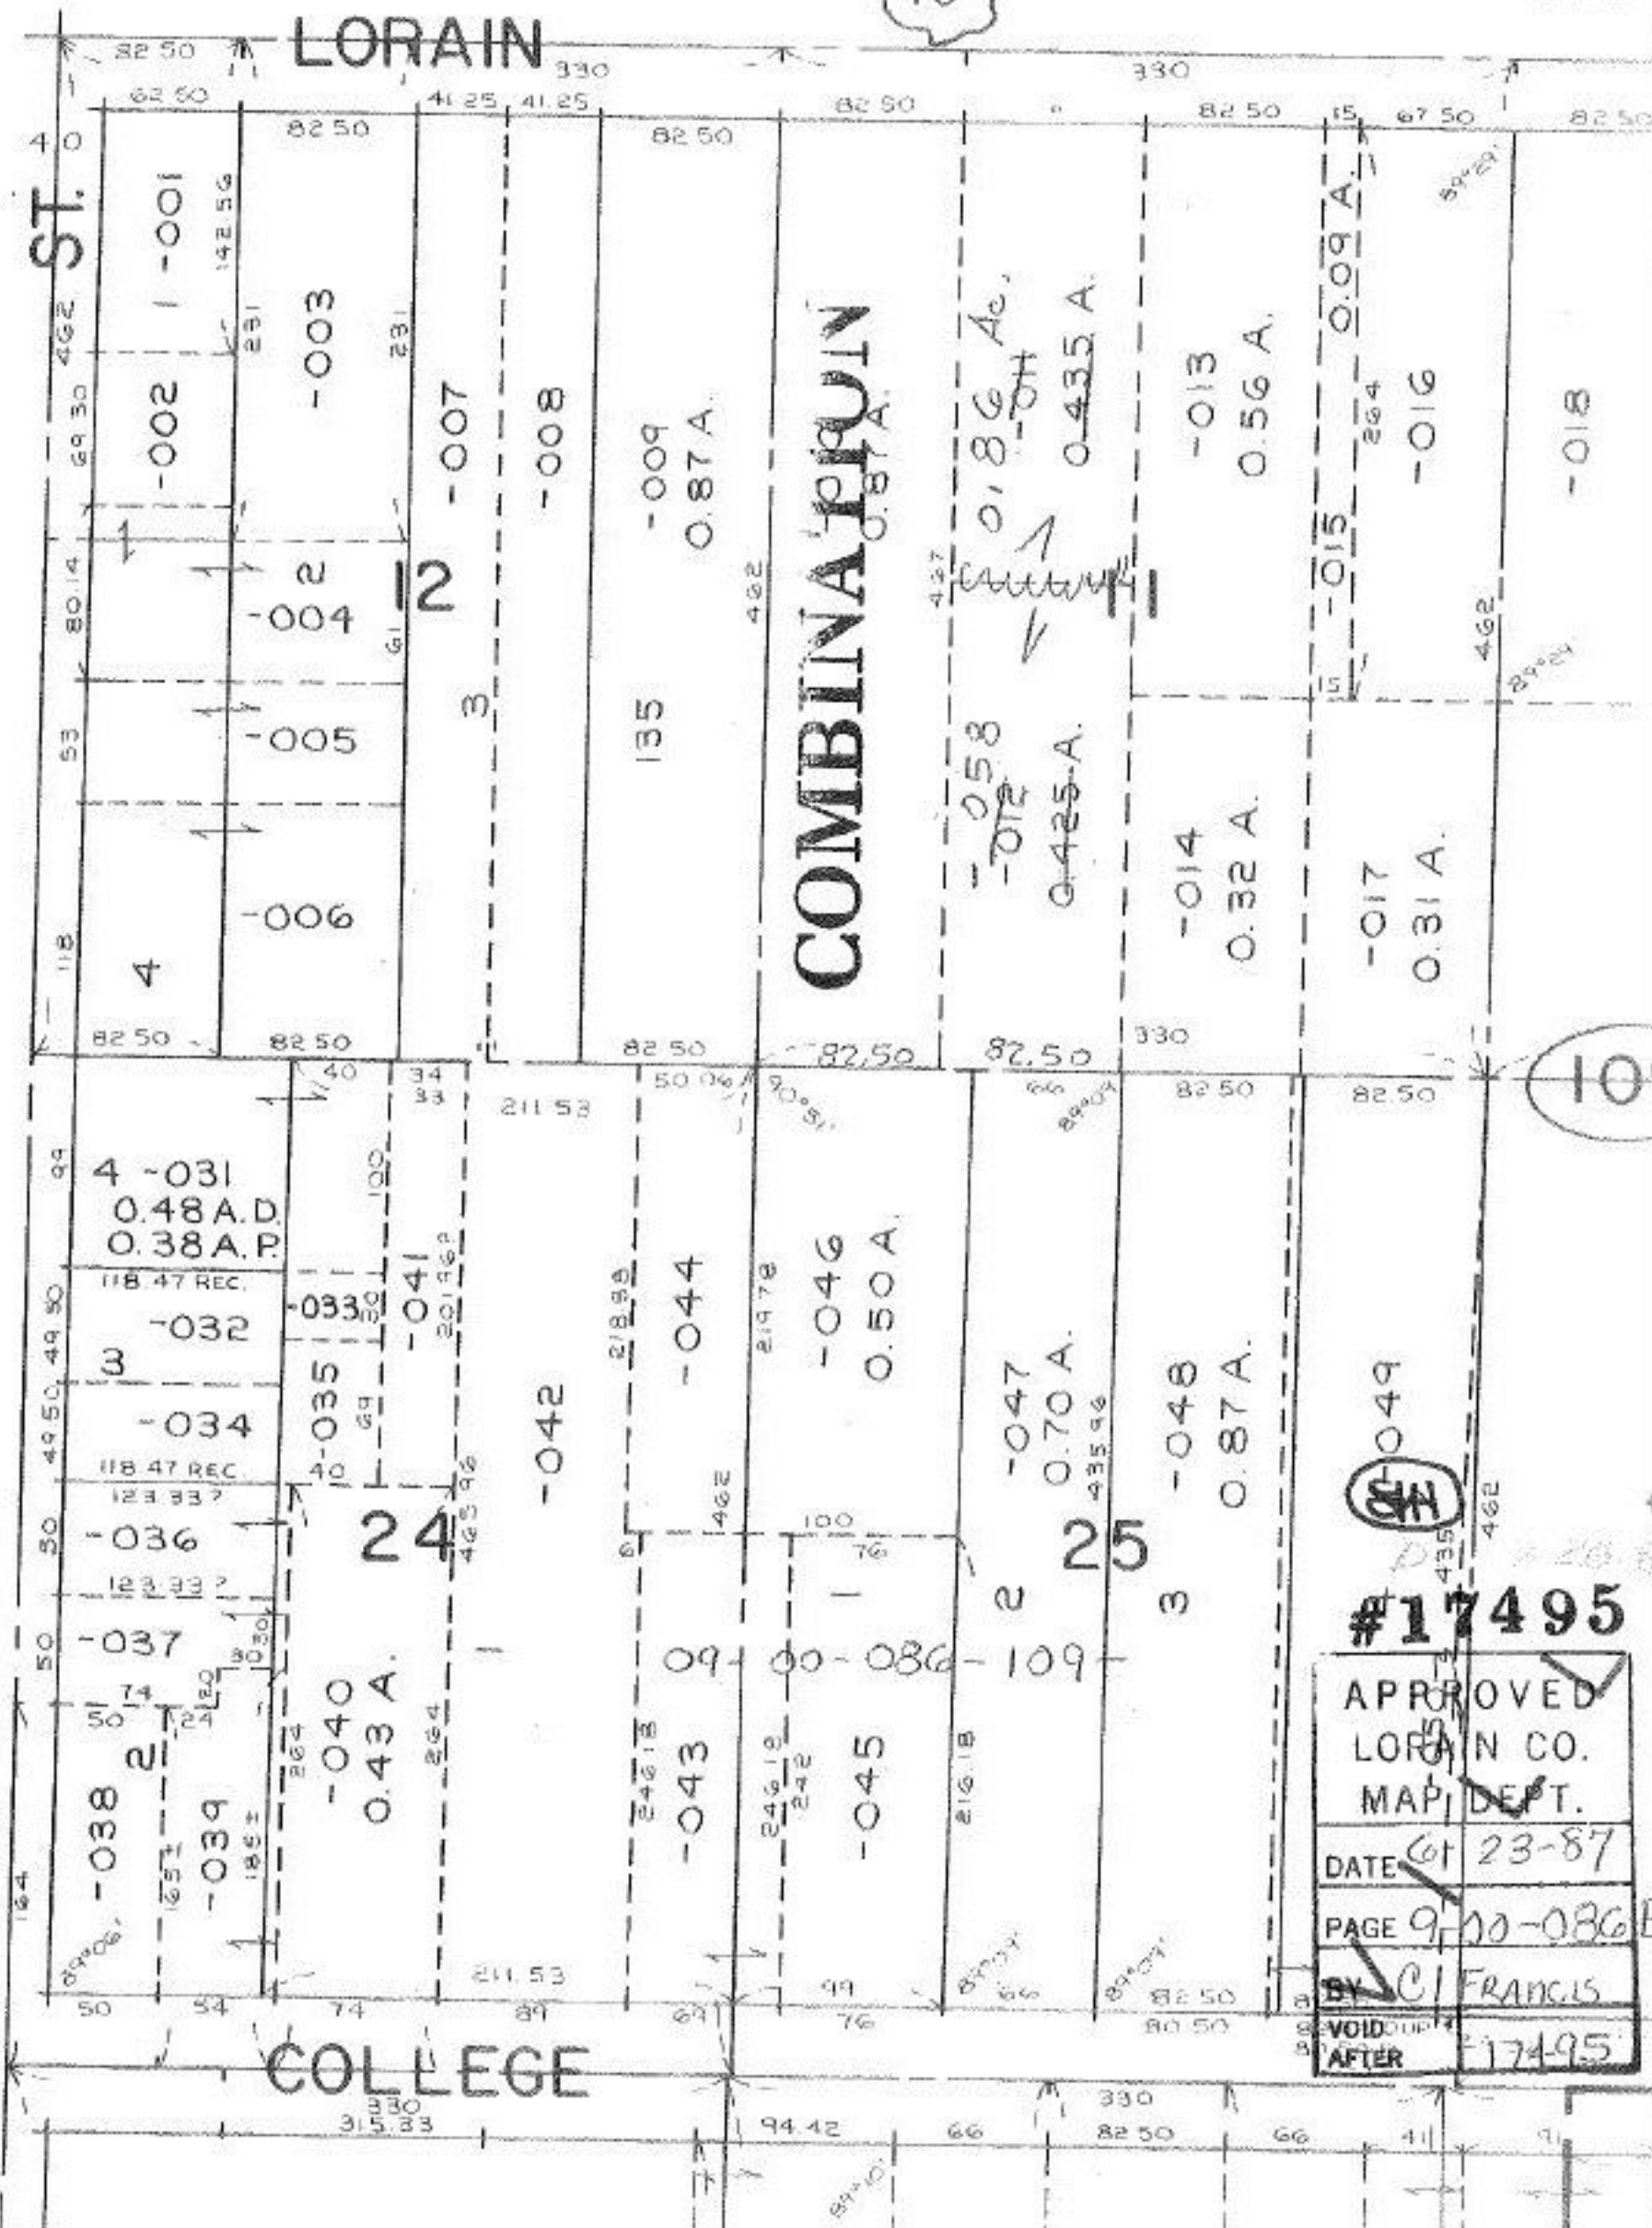

COMBINA TION

#17495

APPROVED	<input checked="" type="checkbox"/>
LORAIN CO.	<input checked="" type="checkbox"/>
MAP DEPT.	<input checked="" type="checkbox"/>
DATE	6/23-87
PAGE	9-00-086 B
BY	C. FRANCIS
VOID AFTER	17495

