


SEE 5-00-083

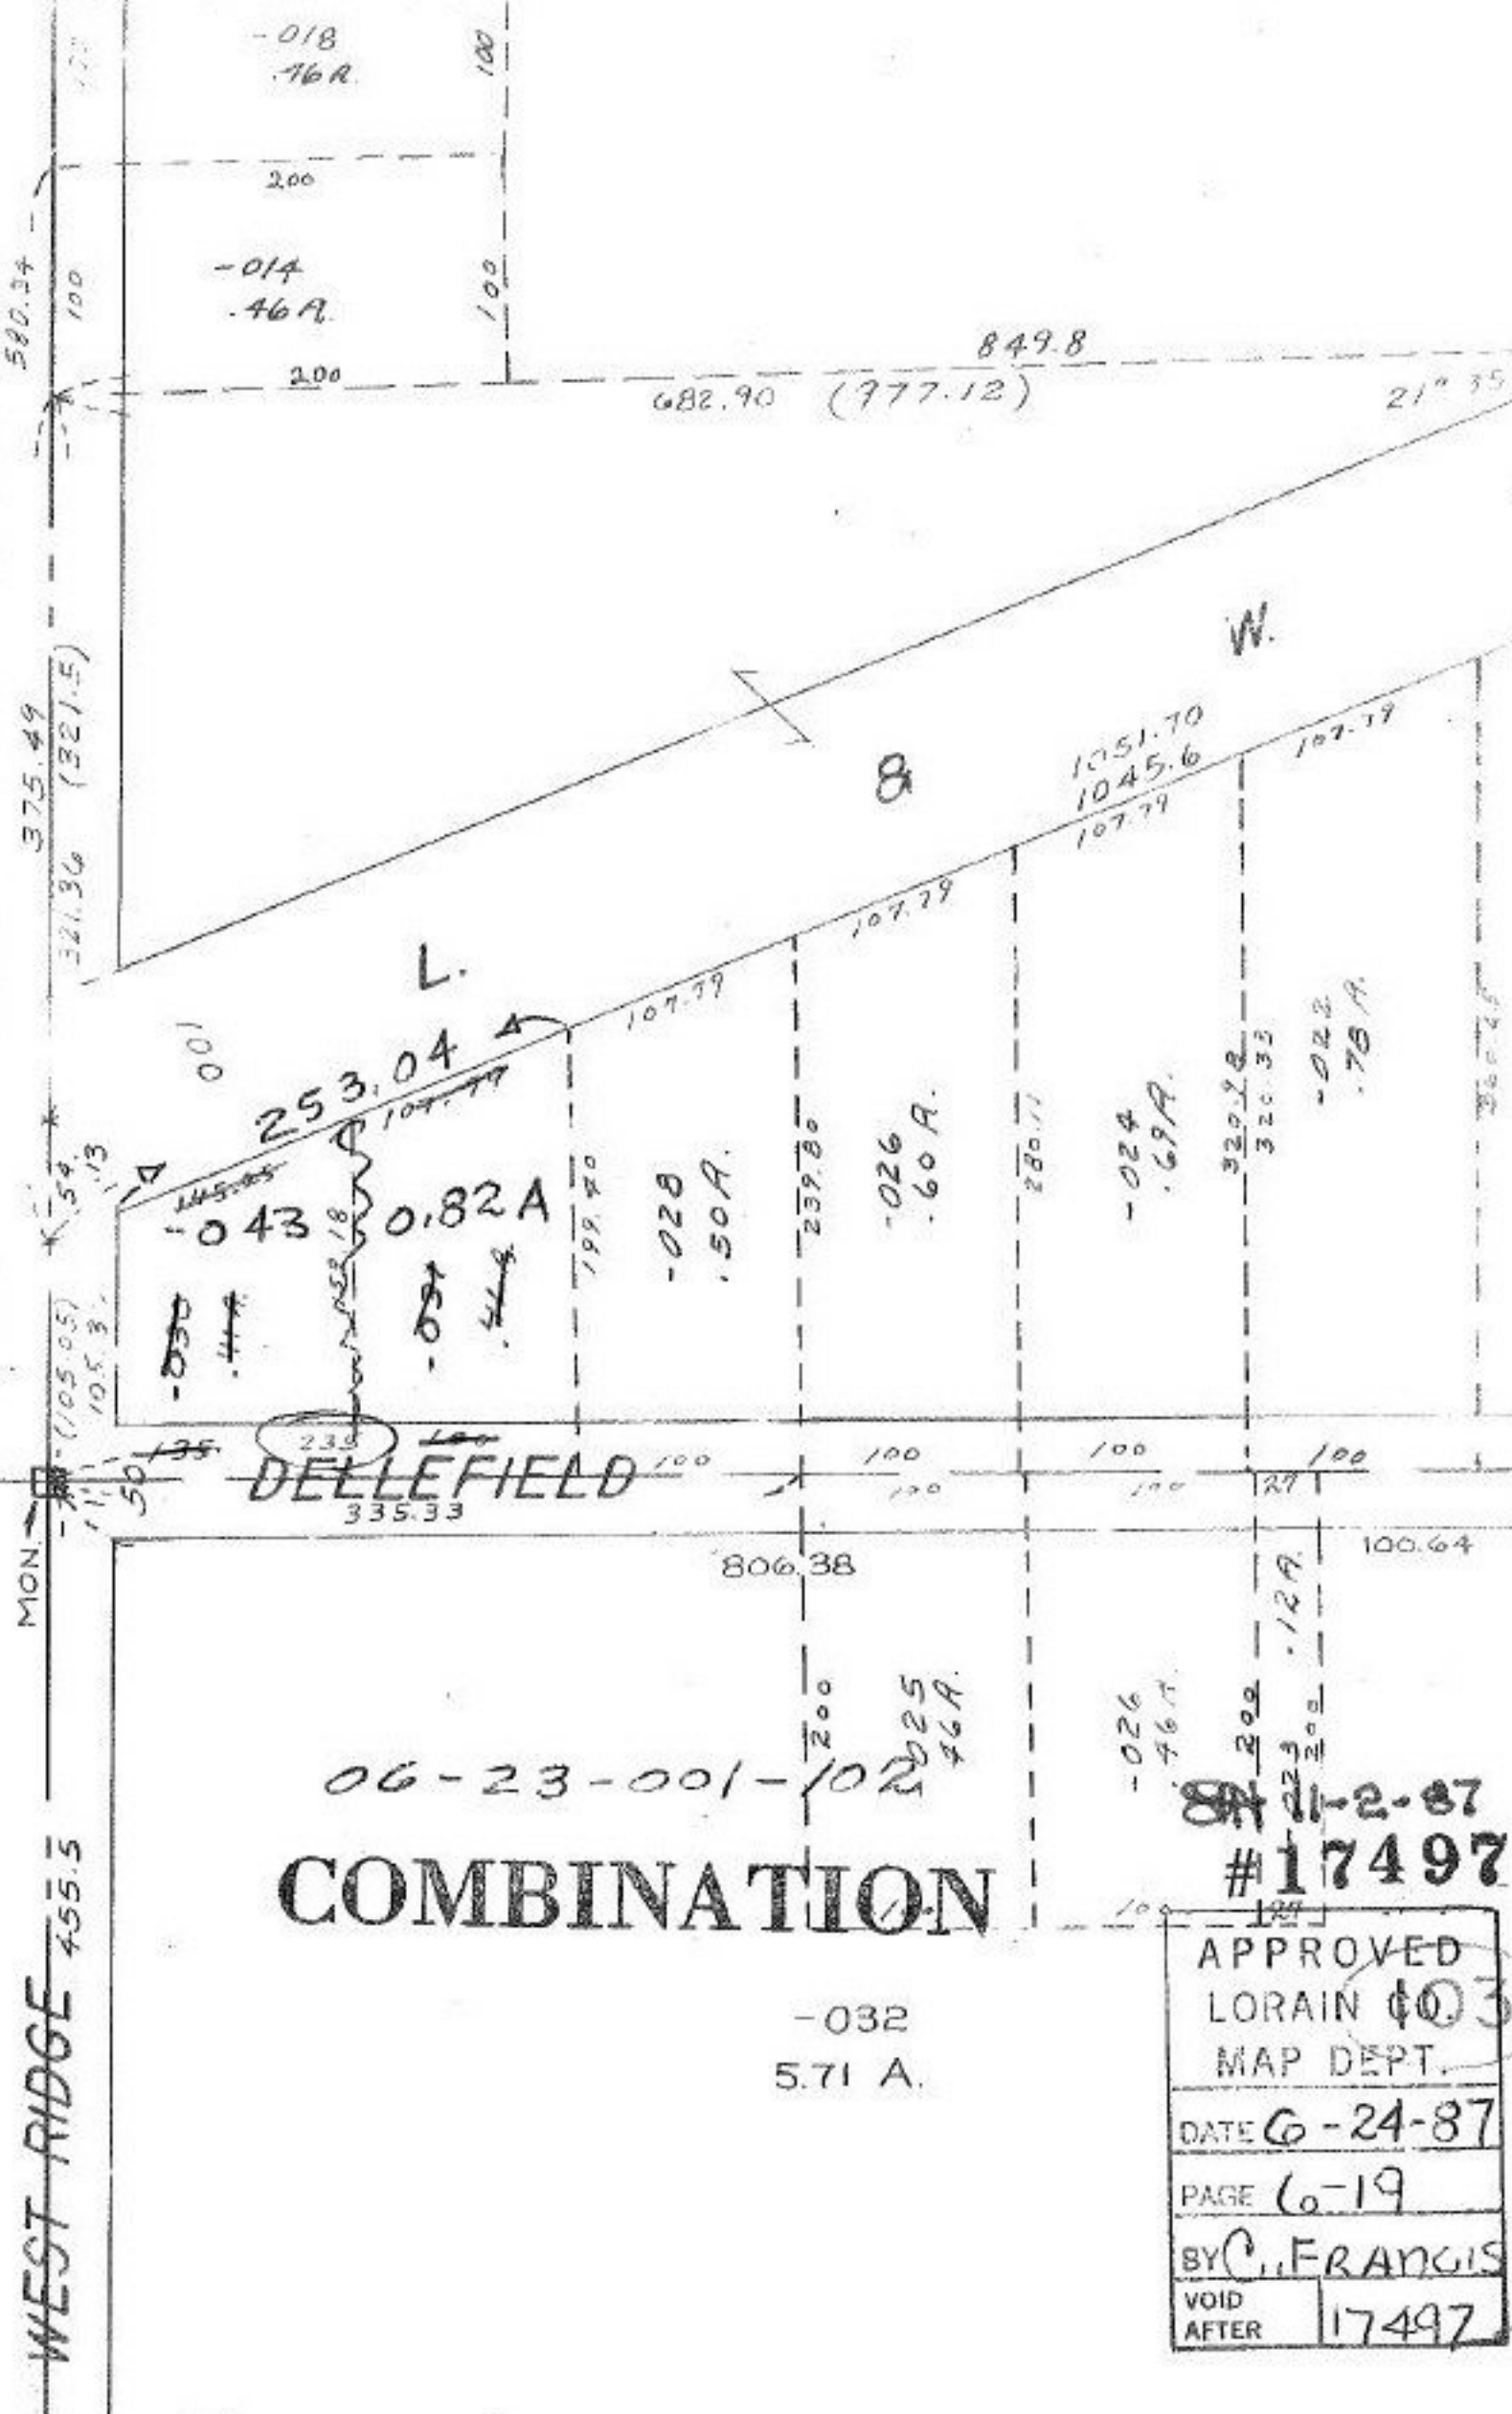

06-23-001-102
COMBINATION

-032
 5.71 A.

21-2-87
 #17497

APPROVED	
LORAIN 103	
MAP DEPT.	
DATE	6-24-87
PAGE	6-19
BY	C. FRANCIS
VOID AFTER	17497