


MAPLE ST. DED. PLAT

SEE 18-C

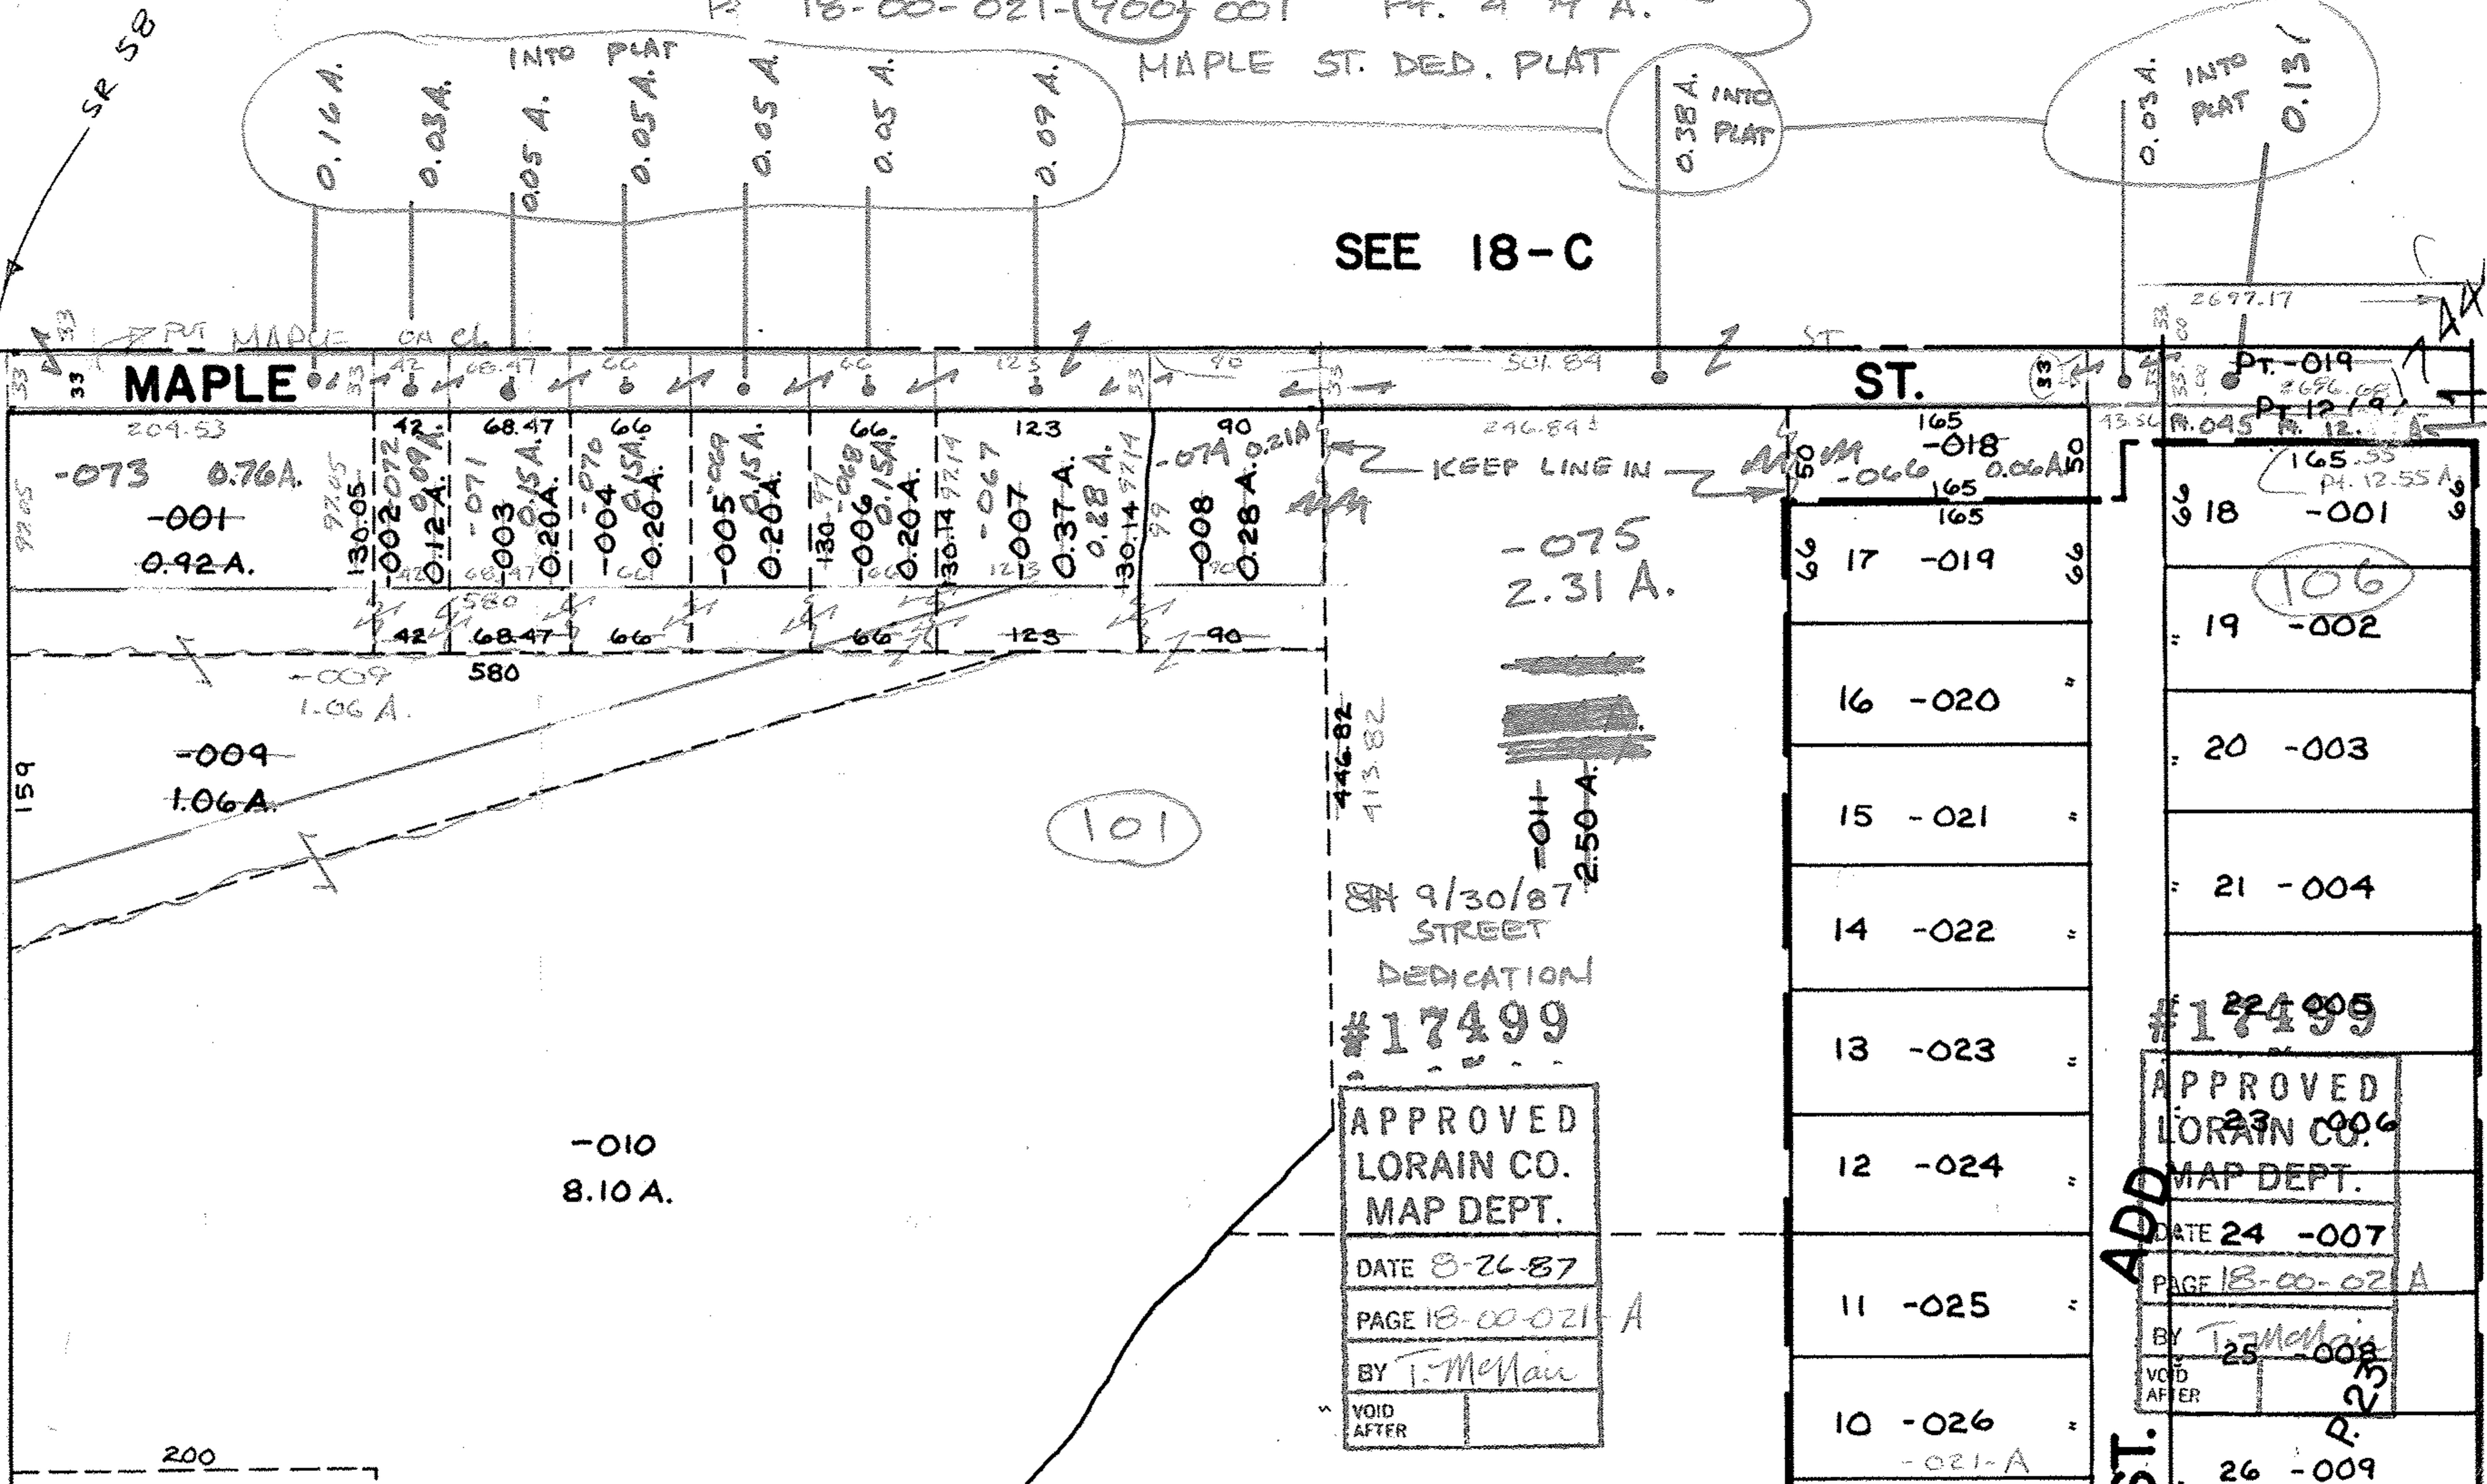

SR 58

MAPLE ST.

ST.

KEEP LINE IN

101

106

9/30/87 STREET DEDICATION

#17499

APPROVED LORAIN CO. MAP DEPT.

DATE 8-26-87

PAGE 18-00-021-A

BY T. McVain

VOID AFTER

#17499

APPROVED LORAIN CO. MAP DEPT.

DATE 24 -007

PAGE 18-00-021-A

BY T. McVain

VOID AFTER

ADD

ST.

-010 8.10 A.

200

26 -009

Pt. -019 #676.00 Pt. 12.19

165.55 Pt. 12.55 A

165 -018 0.06 A

165 -019

16 -020

15 -021

14 -022

13 -023

12 -024

11 -025

10 -026

-021-A

26 -009

Pt. MADE ON CL

204.53 72.65 130.05 002072 42 68.47 66 66 123 90 246.84 165 43.56

-073 0.76A 72.65 130.05 002072 42 68.47 66 66 123 90 246.84 165 43.56

-001 0.92A 72.65 130.05 002072 42 68.47 66 66 123 90 246.84 165 43.56

0.12A 0.071 0.003 0.05A 0.20A 0.004 0.15A 0.20A 130.57 0.068 0.15A 0.20A 30.14 97.14 97 0.071 0.21A 90 0.008 0.28A 30.14 97.14 97

0.071 0.003 0.05A 0.20A 0.004 0.15A 0.20A 130.57 0.068 0.15A 0.20A 30.14 97.14 97 0.071 0.21A 90 0.008 0.28A 30.14 97.14 97

0.009 1.06 A 580 42 68.47 66 66 123 90

0.009 1.06 A 580 42 68.47 66 66 123 90

-009 1.06 A 580 42 68.47 66 66 123 90

-009 1.06 A 580 42 68.47 66 66 123 90

