

MAPLE STREET DEDICATION

SEE 18-C



~~-043~~
~~13.12 A.~~

~~-042~~
~~21.32 A.~~


Pt. -045
Pt. 12.55 A.

~~Pt.~~
~~Pt. 11.54 A.~~

~~Pt. -019~~ 17444
~~Pt. 12.69 A.~~

Pt. -044
Pt. 20.75 A.

106

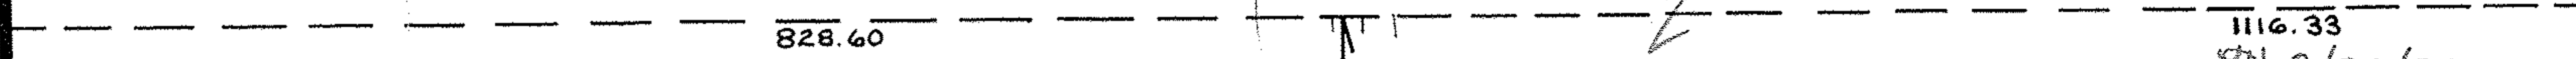

1116.33
9/30/87
STREET

DEDICATION

#17499

APPROVED
LORAIN CO.
MAP DEPT.

DATE 8-26-87

PAGE 18-00-021-B

BY T. McMain

VOID
AFTER

17444

-020
10.00 A.

-021
11.75 A.

-021-B