


SEE 18-C

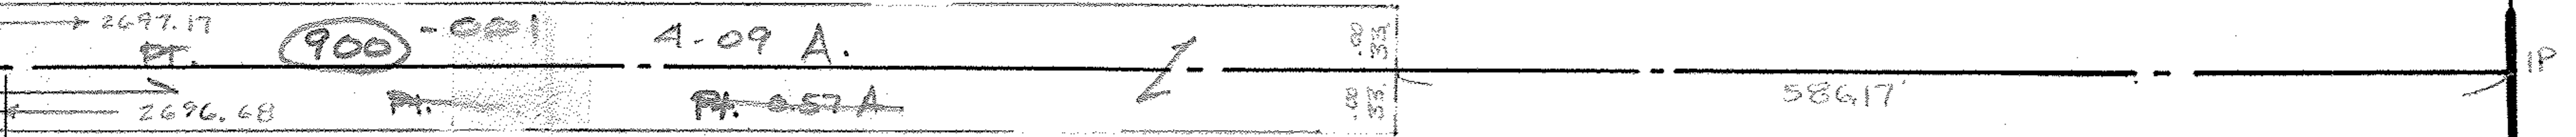

~~PT. 019~~
~~PT. 12.69A.~~

17444

~~PT. 11.54A.~~

~~-042~~
~~21.32A.~~

PT. -044
R. 20.75 A.

1116.33

106

9/30/87
#17499

APPROVED
LORAIN CO.
MAP DEPT.
DATE 8-26-87
PAGE 18-00-021-3
BY T. McHain
VOID AFTER

VILLAGE
TWP.

R. R.

-021-5