

PT. -008
PT. 10.00 A.

2121.54


PT. -009
PT. 5.00 A.

2149.62

PT. -010 *OK 10/1/87*

PT. 5.00 A. ✓

2147.70

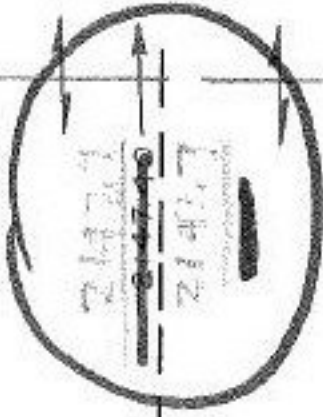

2145.78

PT. -011
PT. 5.00 A. ✓

PT. -012
PT. 5.00 A.

SN 7-15-87

17503

APPROVED	
LUCAIN CO.	
MAP DEPT.	
DATE 6-25-87	
PAGE 10-00-007-	
BY C. FRANGIS	
VOID AFTER	17503

Dee D Checks
Meas. CORR.
ONLY

2143.86

PT. -013
PT. 5.00 A.

2075.75

SEE 10-00-007-G