


SEE 2-01-003-N

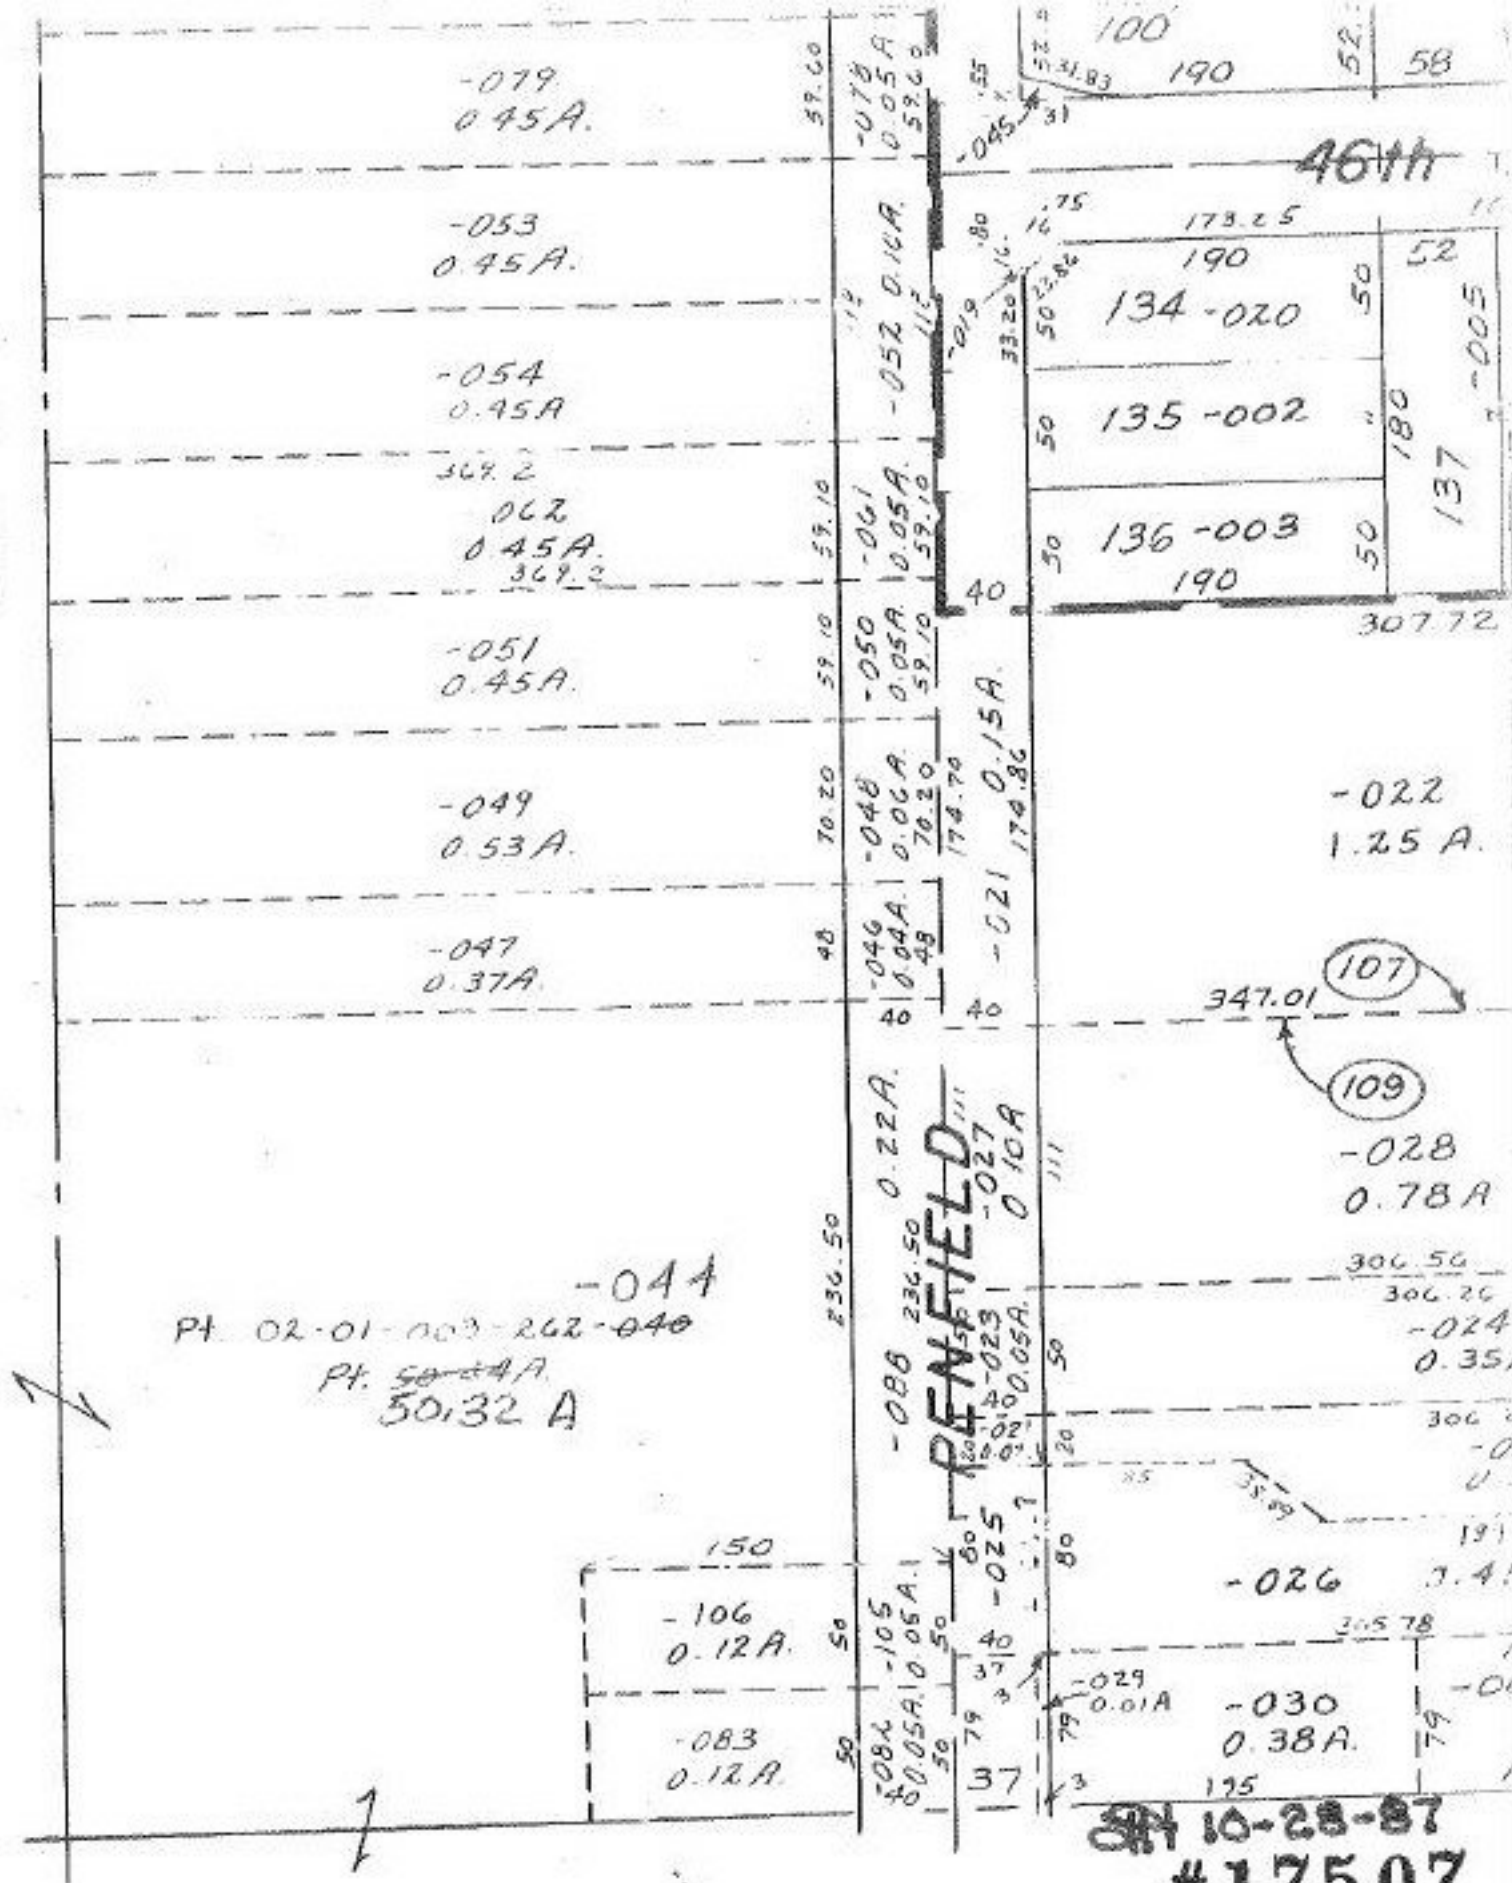

-044  
 Pt. 02-01-003-262-040  
 Pt. 50-32A  
 50:32 A

10-28-87  
 #17507

APPROVED  
 LORAIN CO.  
 MAP DEPT.  
 DATE 7-1-87  
 PAGE 3-00-108-A  
 BY SHEPHERD  
 VOID AFTER 17507

Copyright 1964  
 5-4-87

3-00-108-A

SHEPHERD  
 SCALE: 1" = 100'