


SEE 4-00-024-G

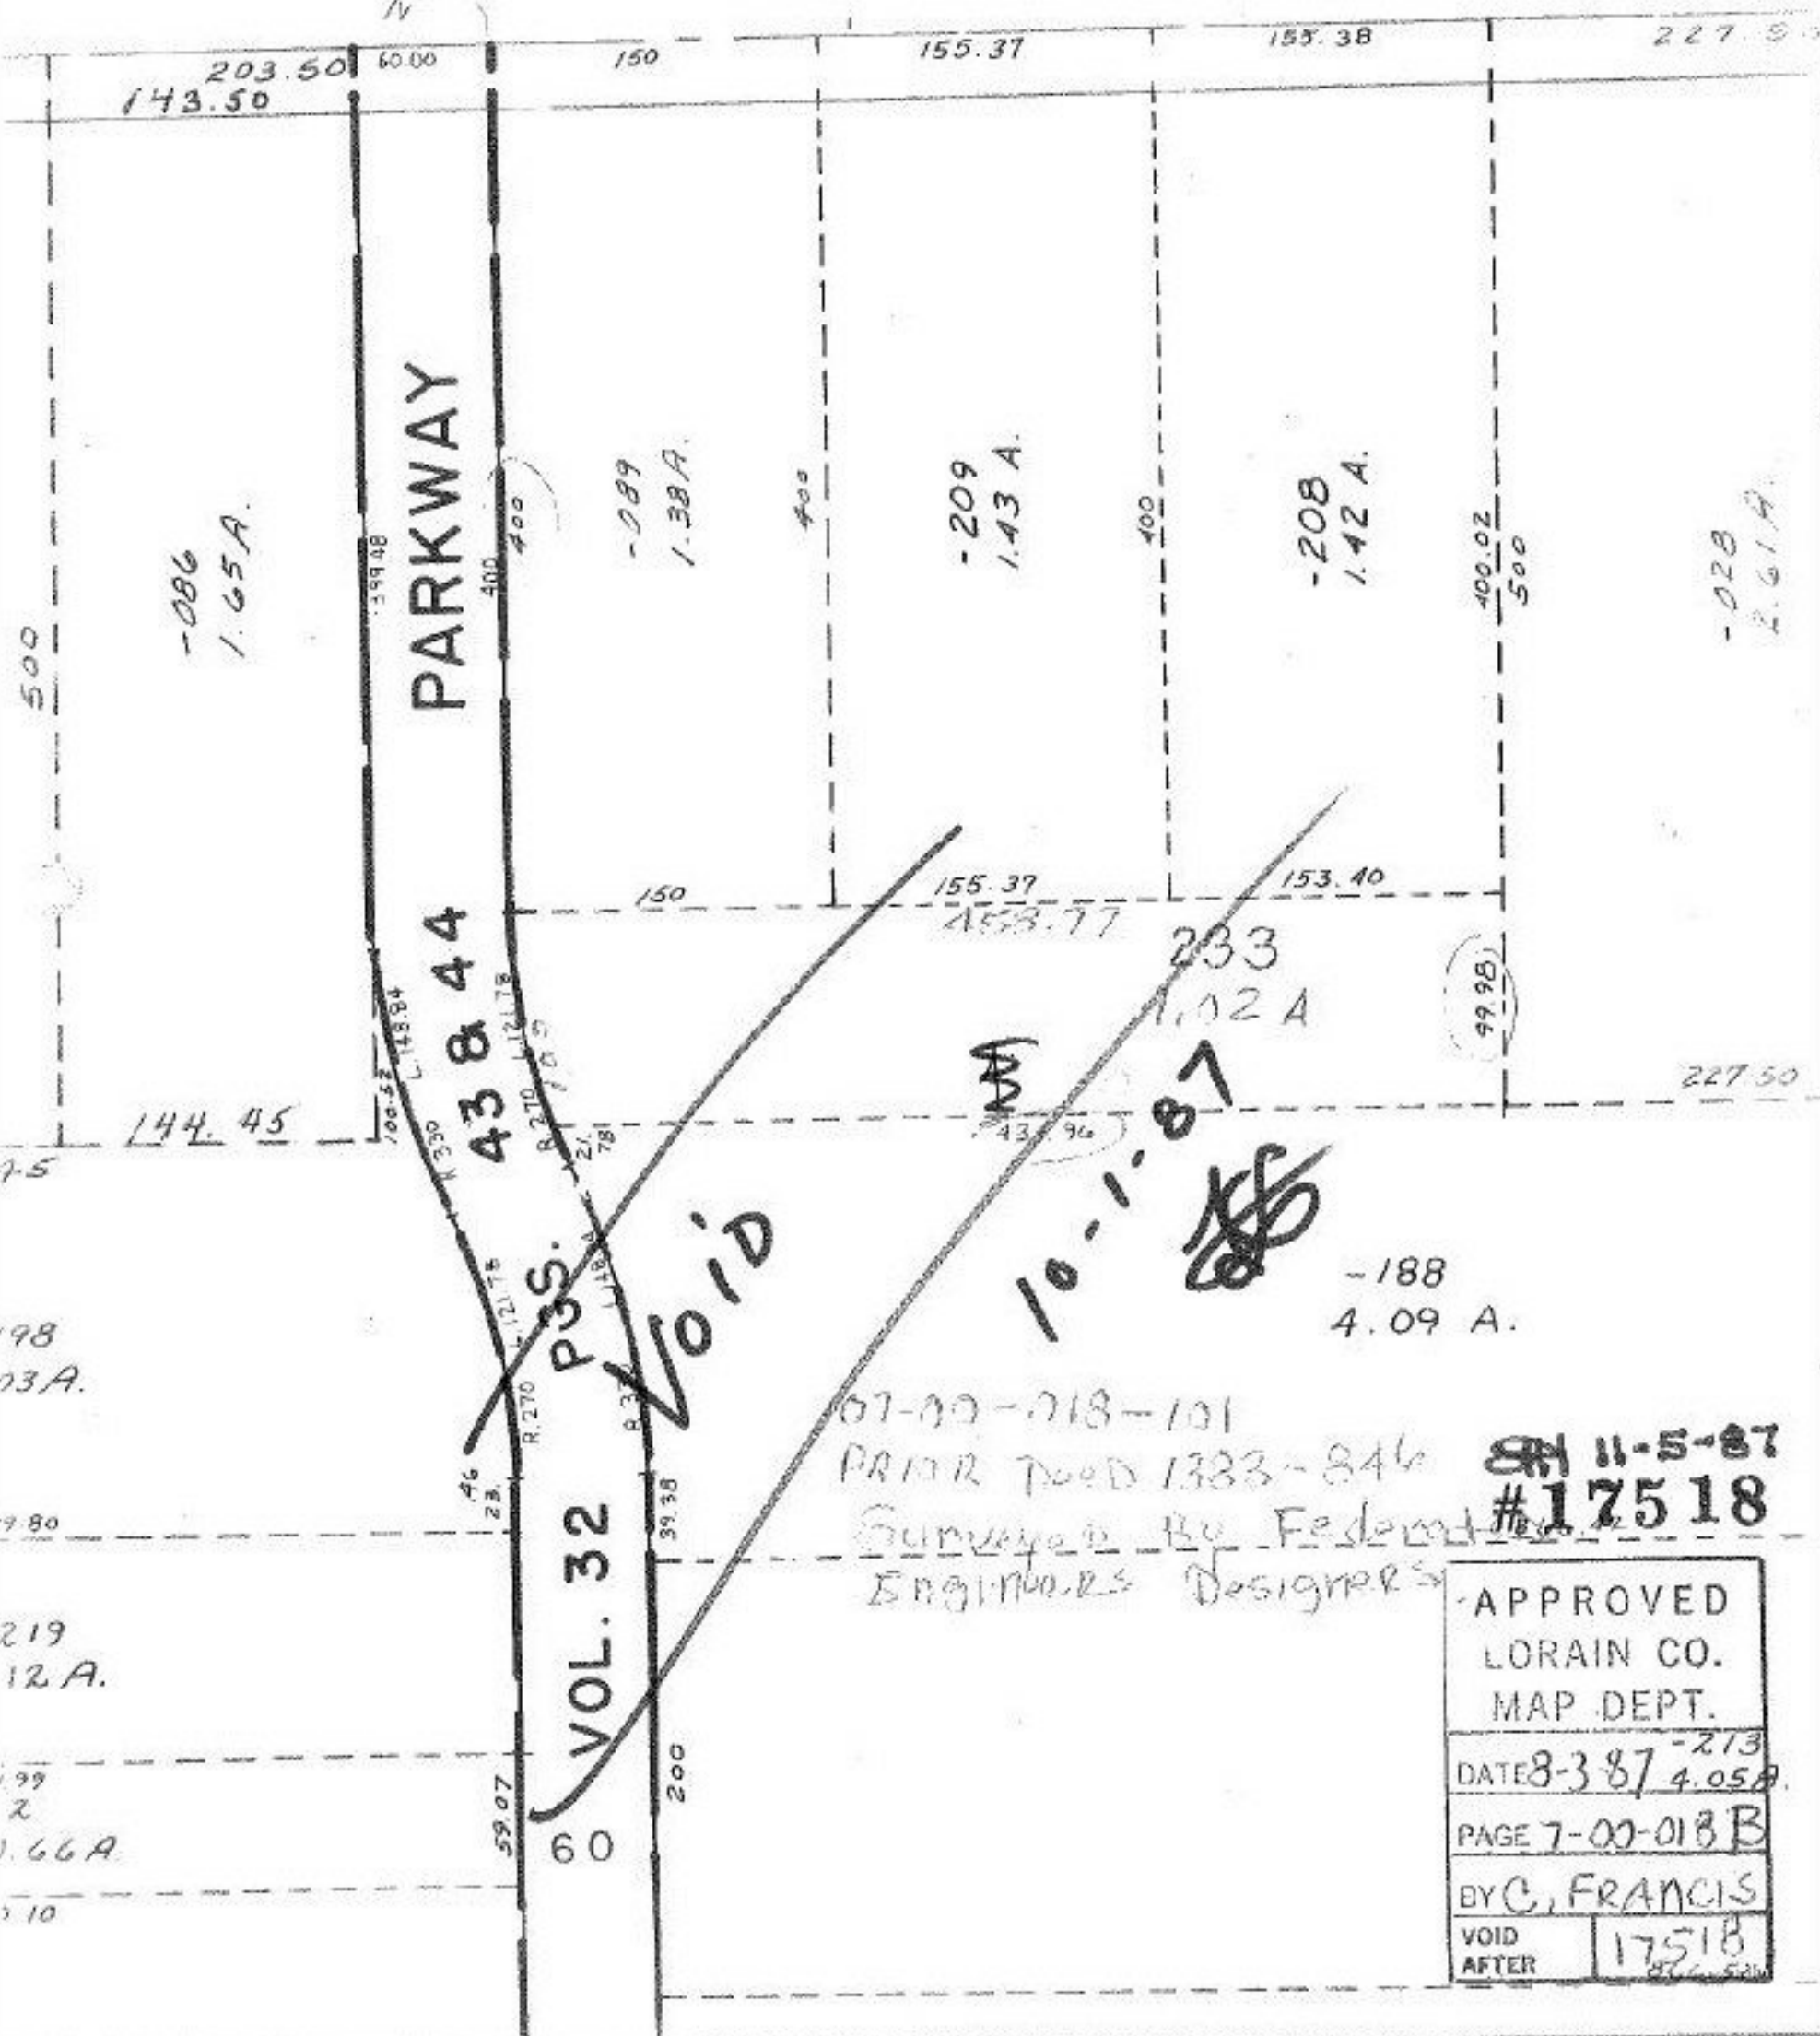

07-00-018-101
 PROR. ROAD 1383-846
 Surveyed By Federation
 Engineers Designers

11-5-87
 #17518

APPROVED LORAIN CO. MAP DEPT.	
DATE 8-3-87	-213 4.058
PAGE 7-00-018 B	
BY C. FRANCIS	
VOID AFTER	17518