


PORTMAN

RD.

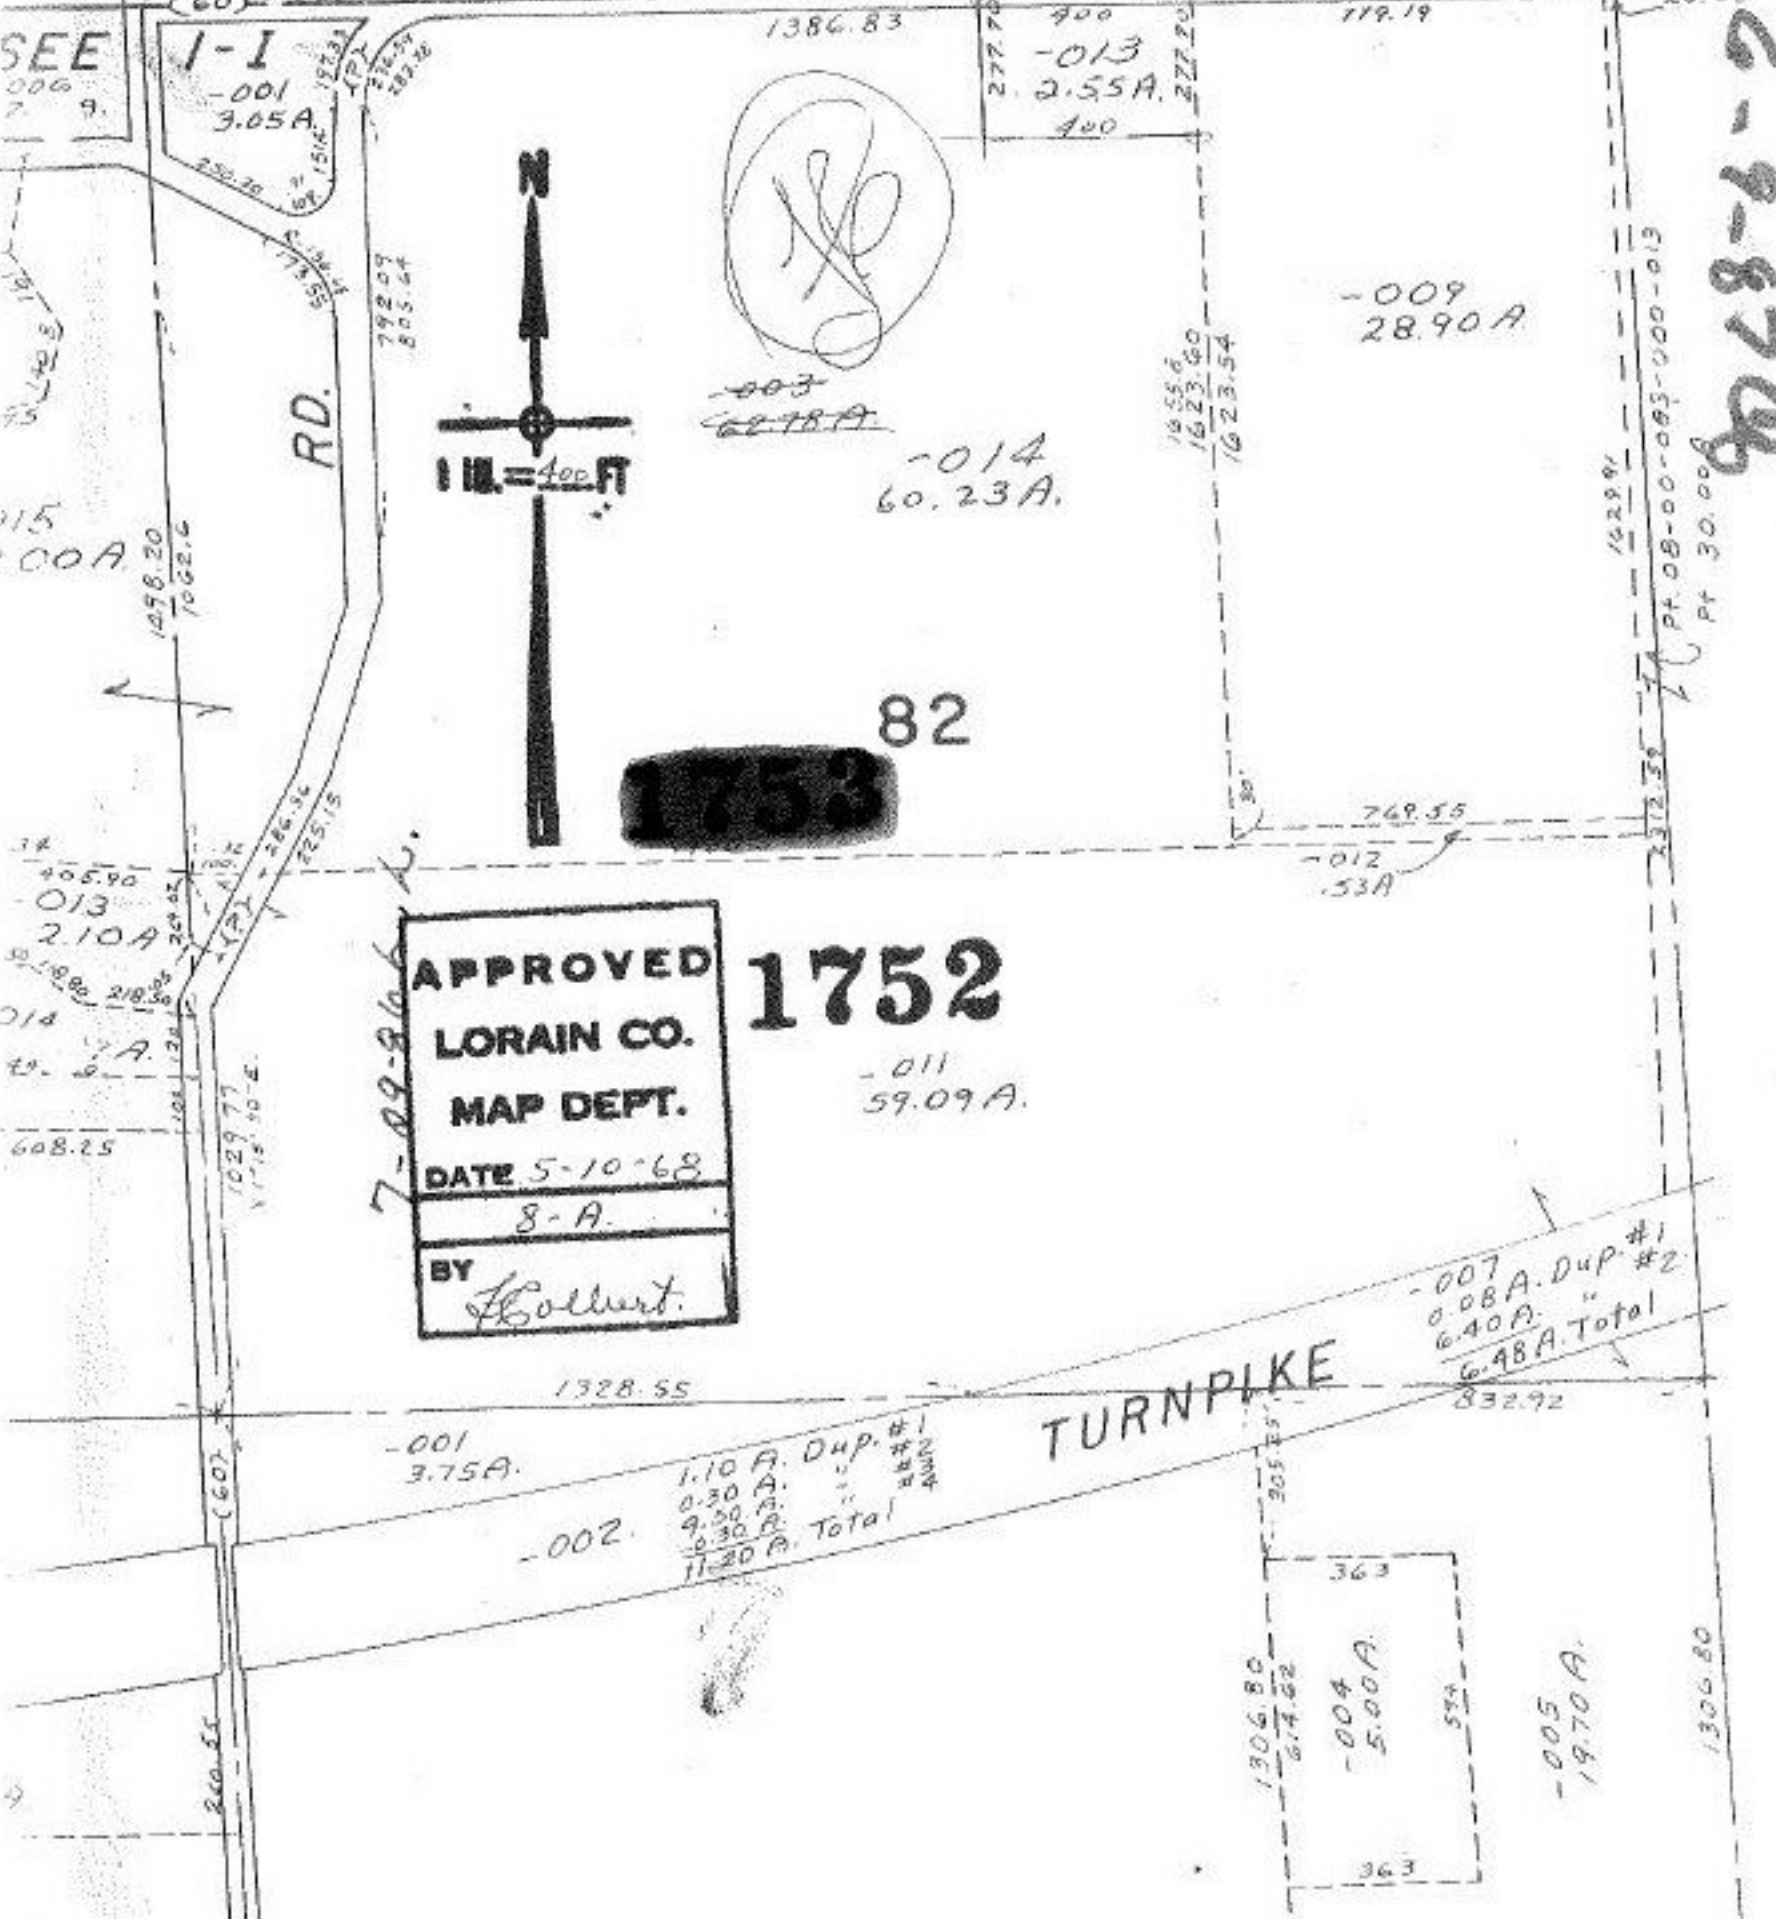

APPROVED  
 LORAIN CO.  
 MAP DEPT.  
 DATE 5-10-68  
 8-A.  
 BY  
 Hollert.

1752

TURNPIKE

DONE 2/10/68

H. Kocich

9048706