

434.50


77

77

2078.33

~~-021~~    -061  
~~20.00 A.~~    18.91 A

2082.04

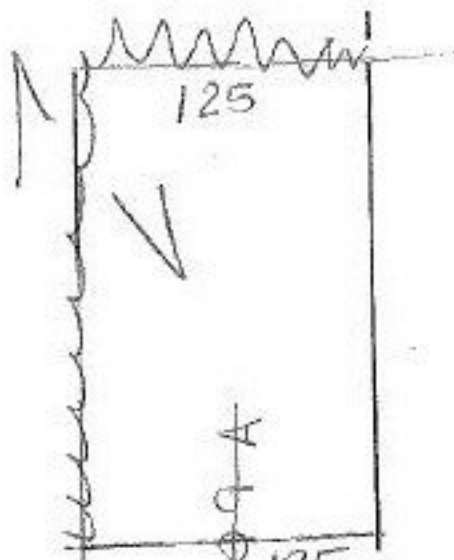

12-00-082-000  
 PRIOR Deed 1353-284  
 Surveyed by: W.B.  
 Barton Reg. Surveyor  
 C=1. INF

**SA**  
 RC. 7.21.87

#17529

APPROVED LORAIN CO. MAP DEPT.	
DATE 7-3-87	
PAGE 12-00-082-0	
BY C. Francis	
VOID AFTER	17529

309.47

RD. 125 0  
9