


Pt. -139
Pt. ~~215.95 A.~~
209.36 A.

SN 7-15-87
17531

APPROVED
FOR THE
MAP DEPT.
DATE 7-7-87
PAGE 10-00-012 A
BY <i>J. Belmont</i>
VOID AFTER 17531

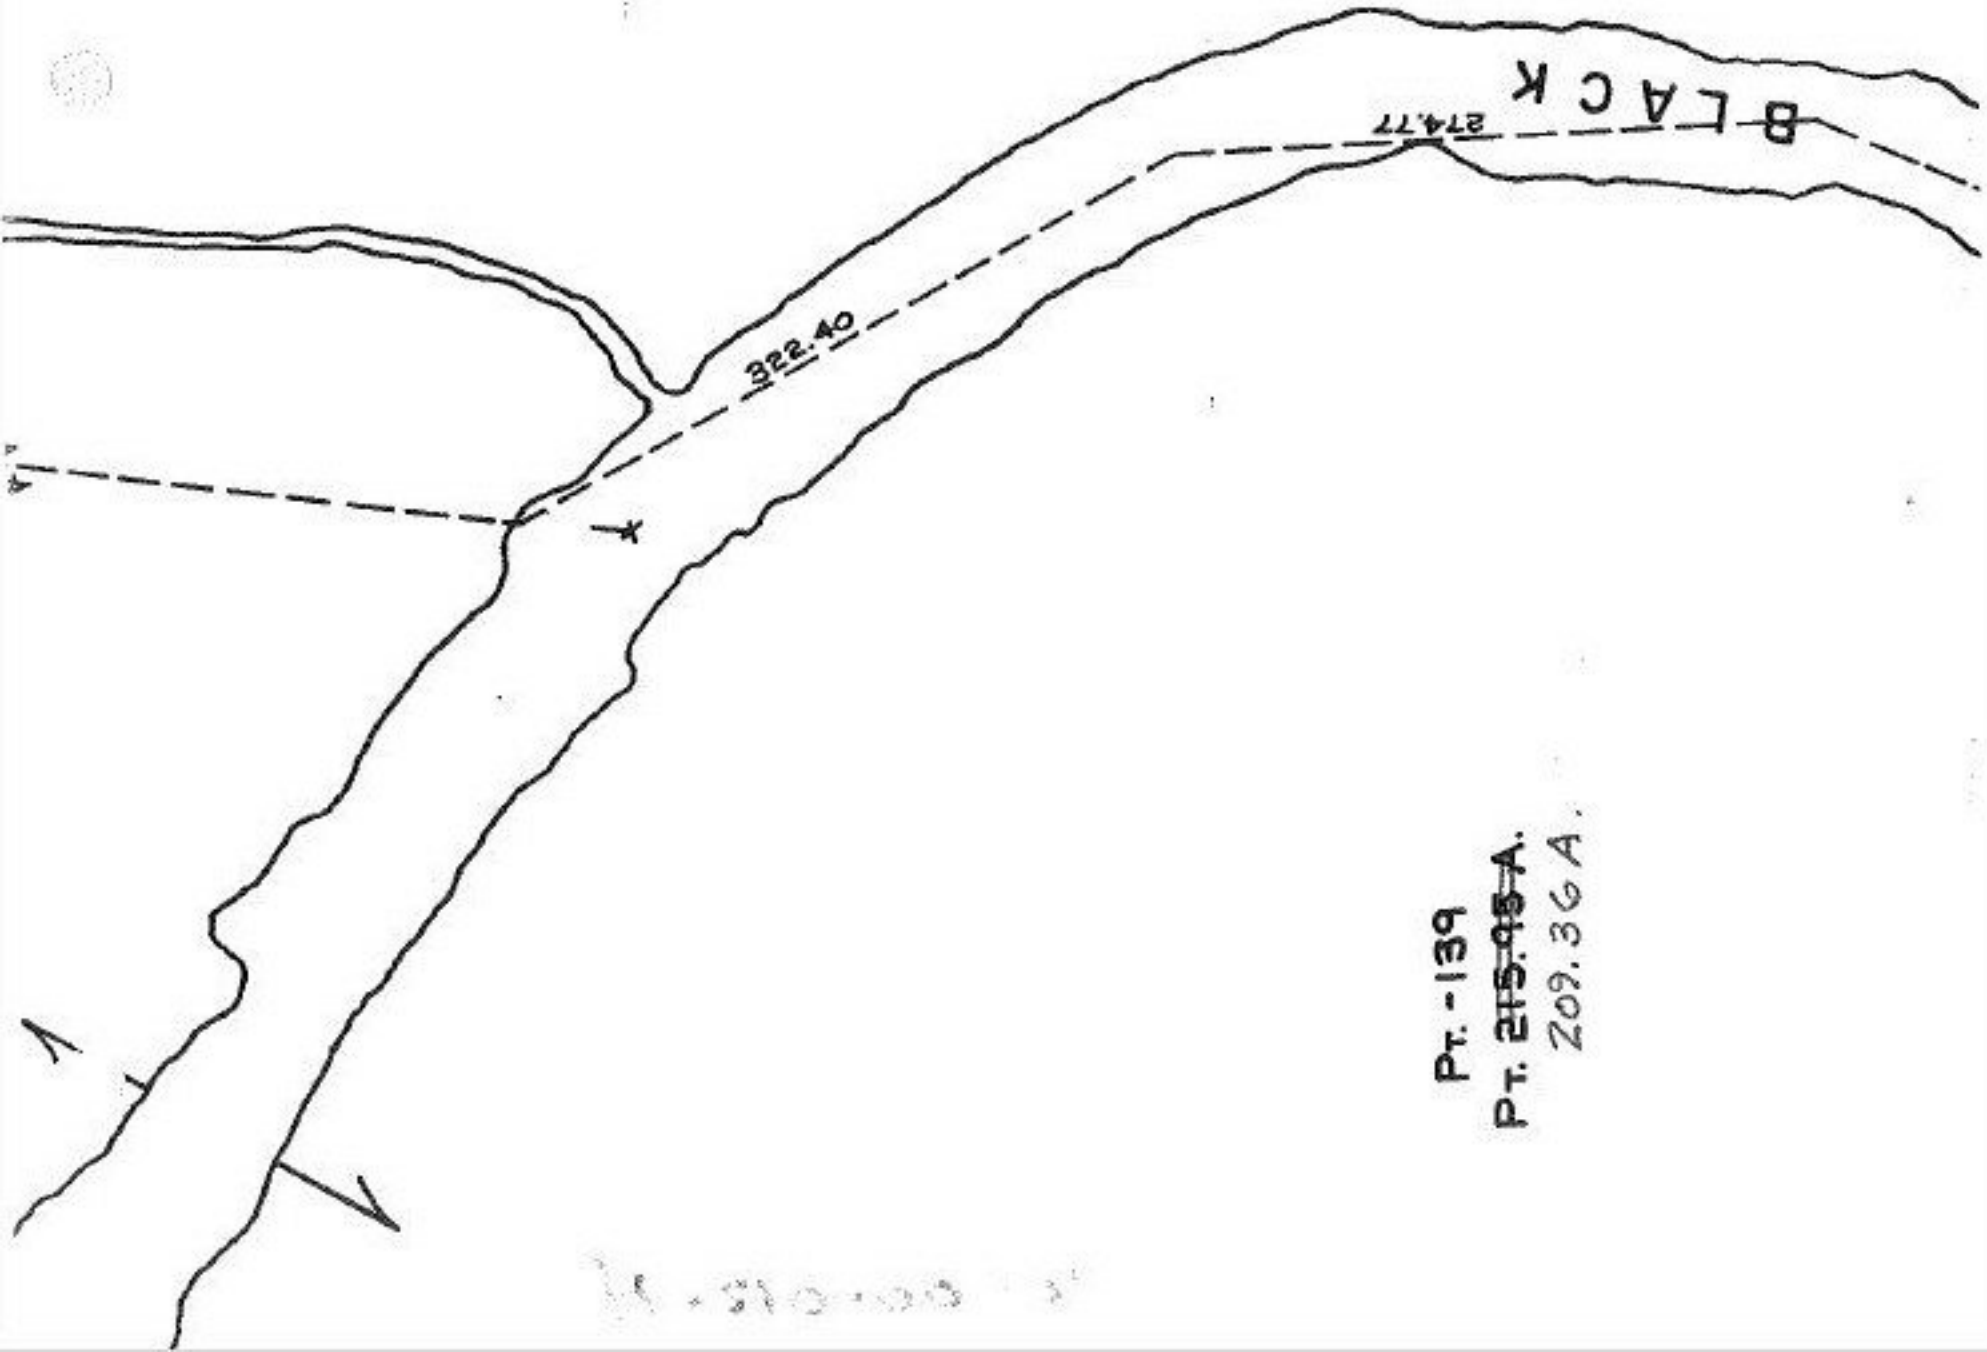

Pt. -139
Pt. ~~215.95 A.~~
209.36 A.