


M

125.48

120

125

143.34

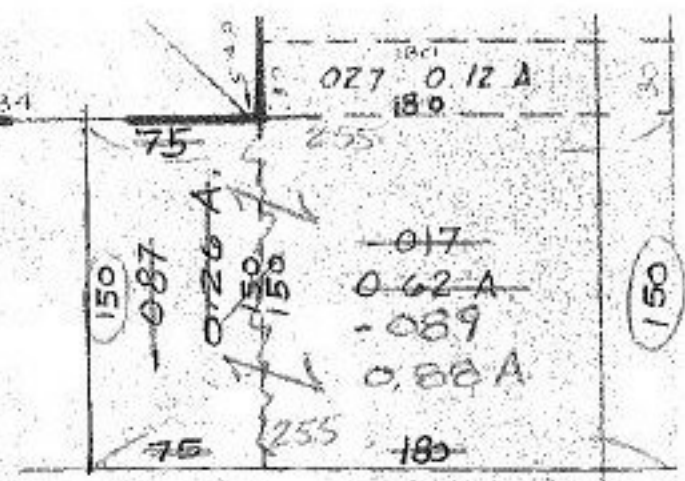

104

- 088  
39.51 A

~~016~~  
~~39.77 A~~

# COMBINATION

#17533

SN 10-29-87

~~#17456~~

04-00-020-104-  
Prior Dec D 4/60

7/8/87

4-00-020-D

T. McMain

APPROVED MAIN CO. MAP DEPT.	
DATE	<del>6-3-87</del>
PAGE	A-00-020-D
BY	<del>Francis</del>
VOID AFTER	17456