


24-UT1

5.91 A.

403.68
250
153.68

399.21
250
149.21

17537

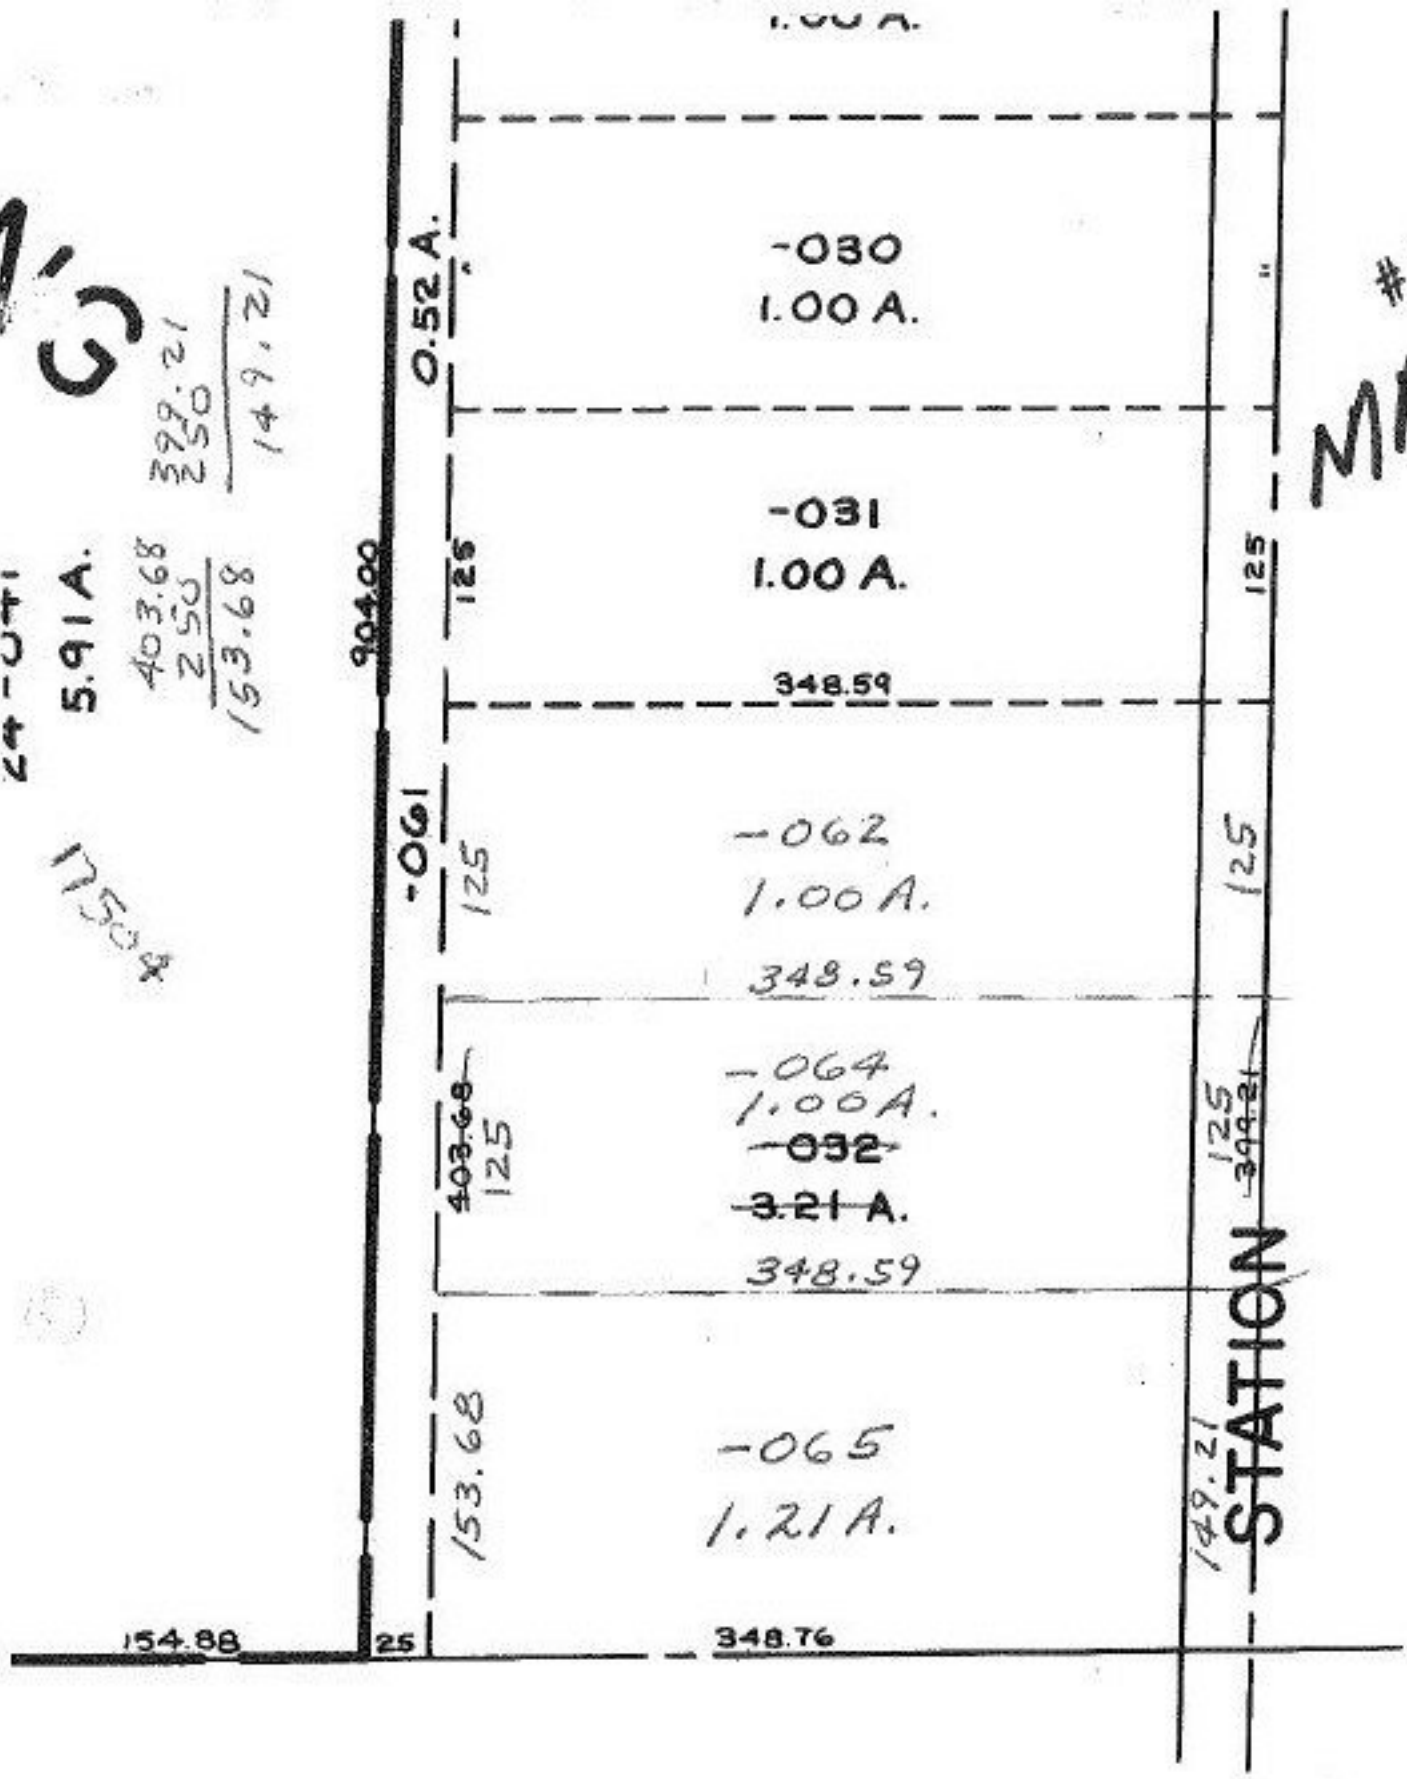

#17537
MAP CORRECTION
ONLY

MS

7-21-87

#17537

APPROVED LORAIN CO. MAP DEPT.	
DATE 7-9-87	
PAGE 12-00-088 B	
BY <i>[Signature]</i>	
VOLD AFTER	17537

REVISED 4-15-86

B

PT. LOT 88

12-00-088-