


D-B



~~055~~  
~~27.56A~~

A. 17559 27.12 A.

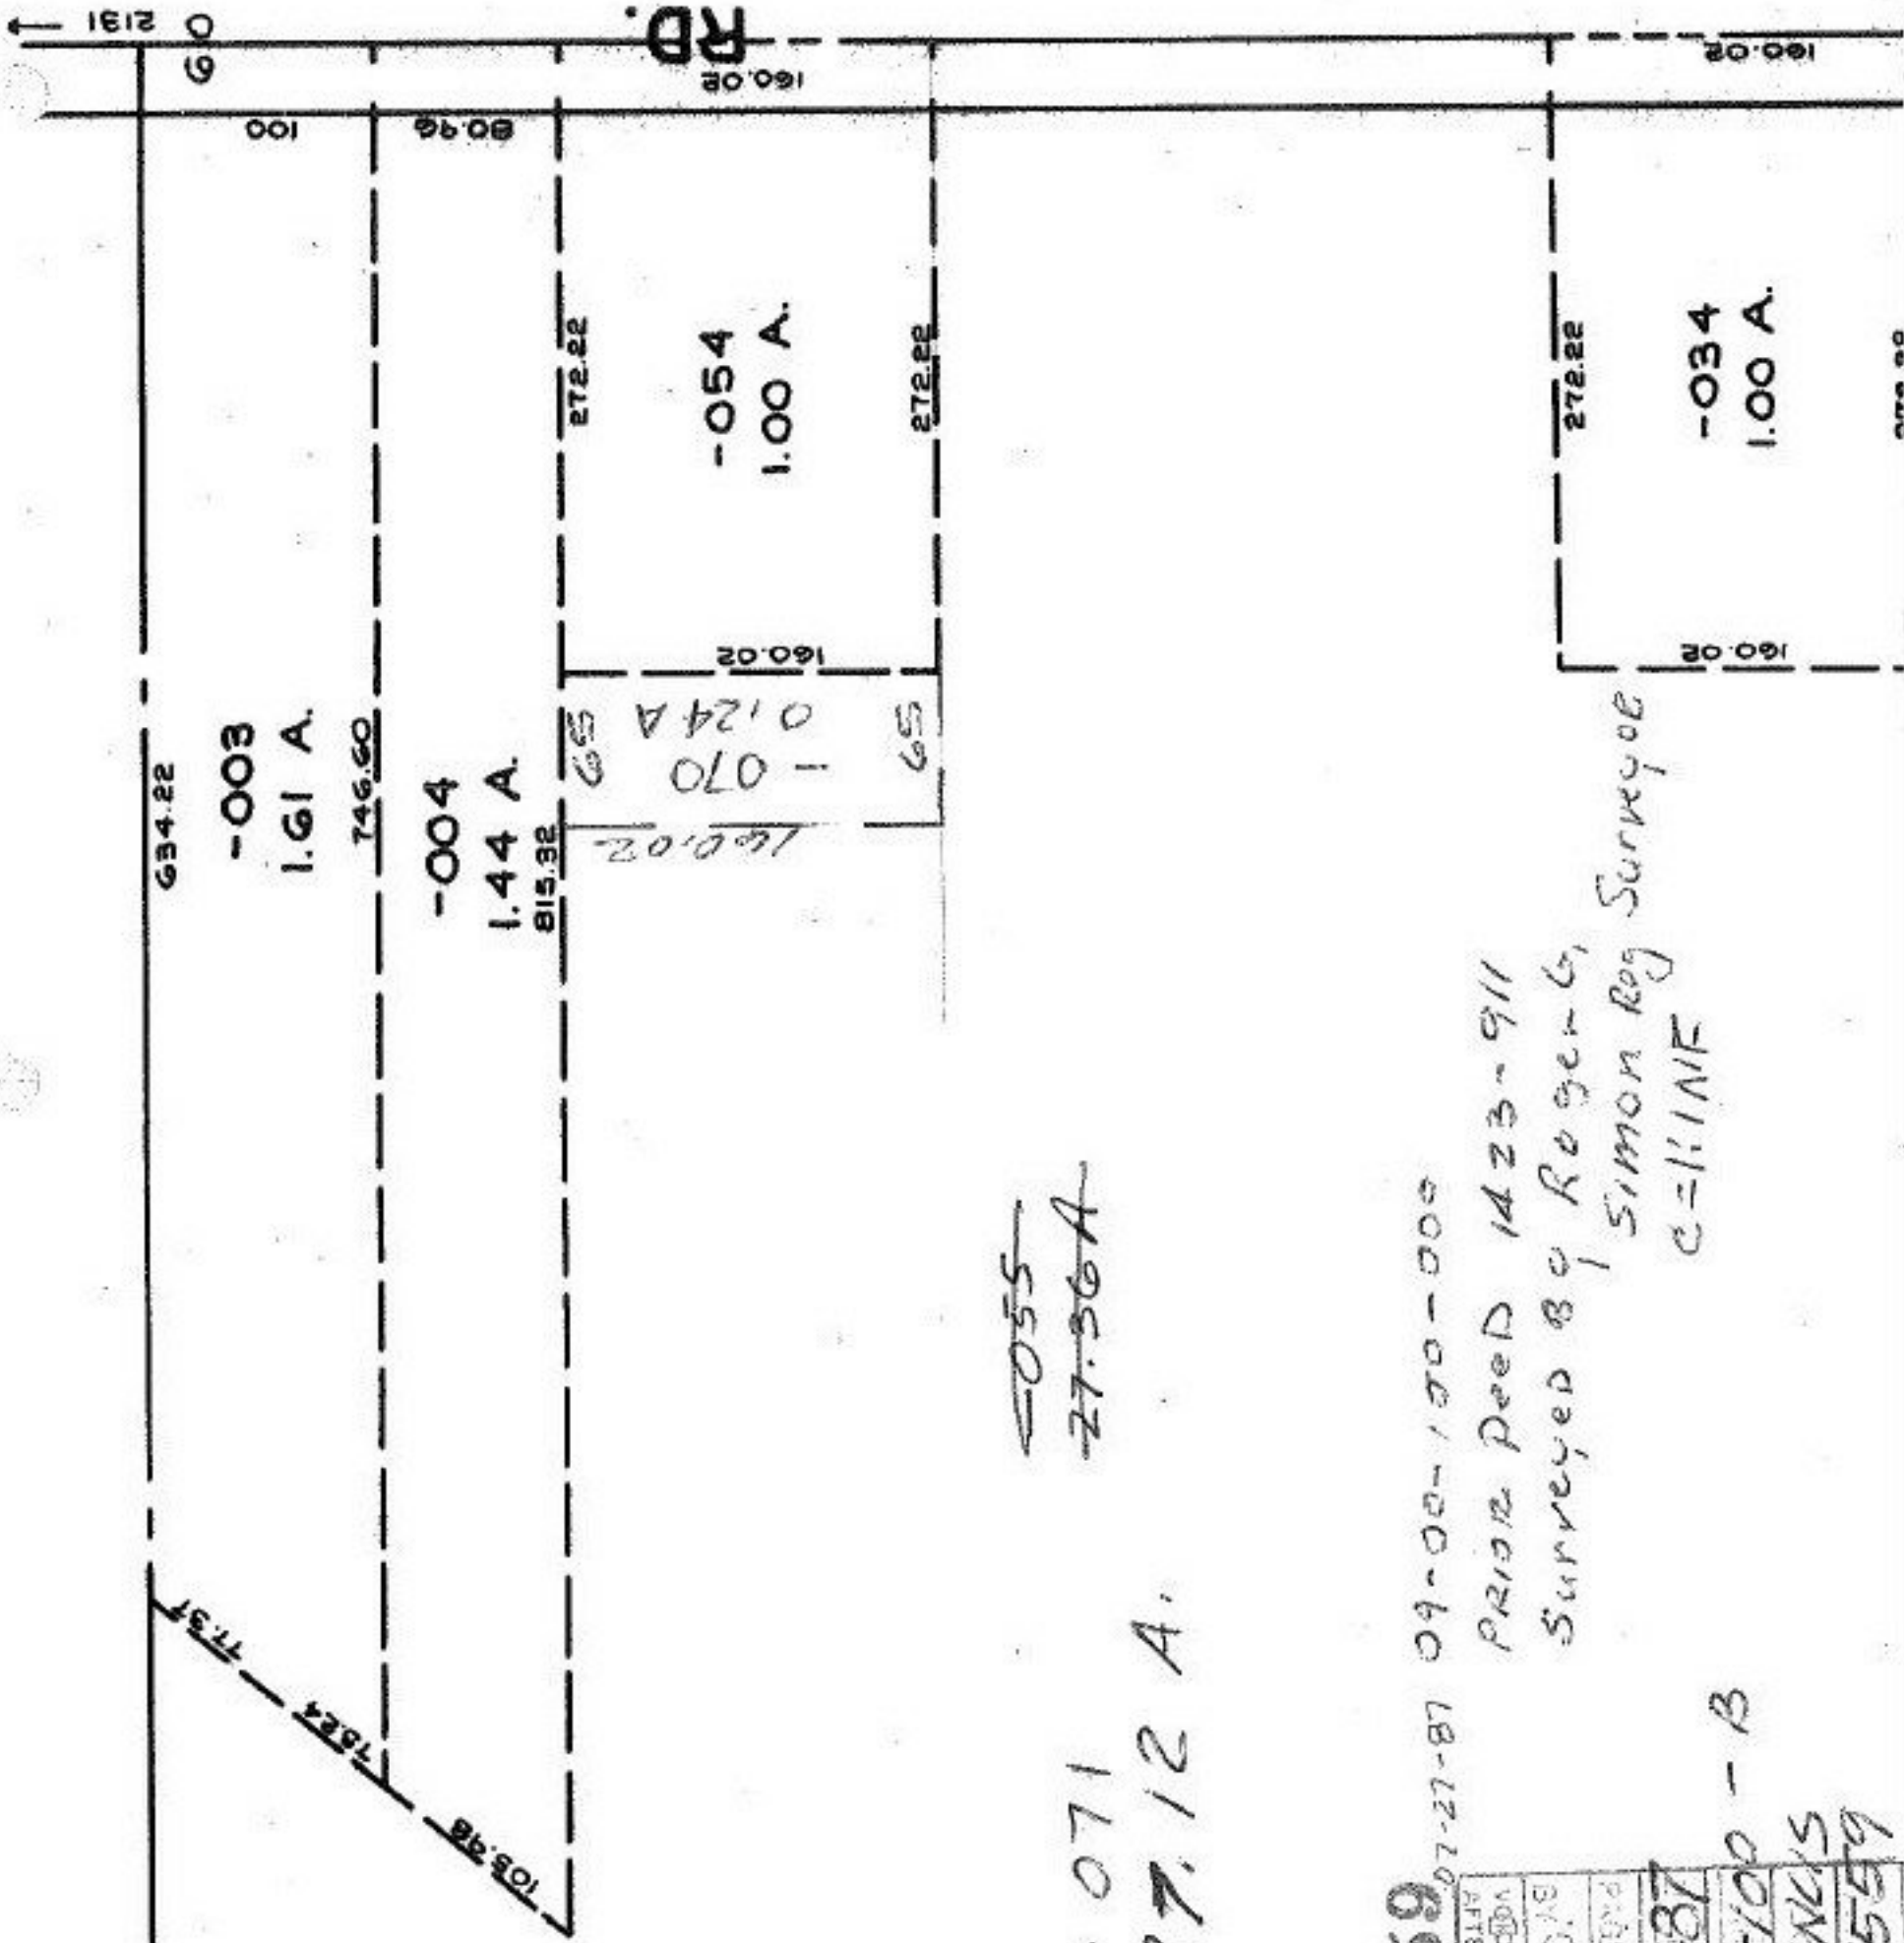

#17559

APPR BY	RELI
AFTER	EDDA
LORAIN CO. INC	
MAP DEPT	
DATE	7-24-87
PAGE	9-00-100 - B
BY	C. FRANCIS
VOL	17559
AFTER	

07-27-87 09-00-100-000

PRIOR PLOTTED 1423-911  
 Surveyed by Roger G. Simon Reg Surveyor

C=LINE

-034  
 1.00 A.