



TATE

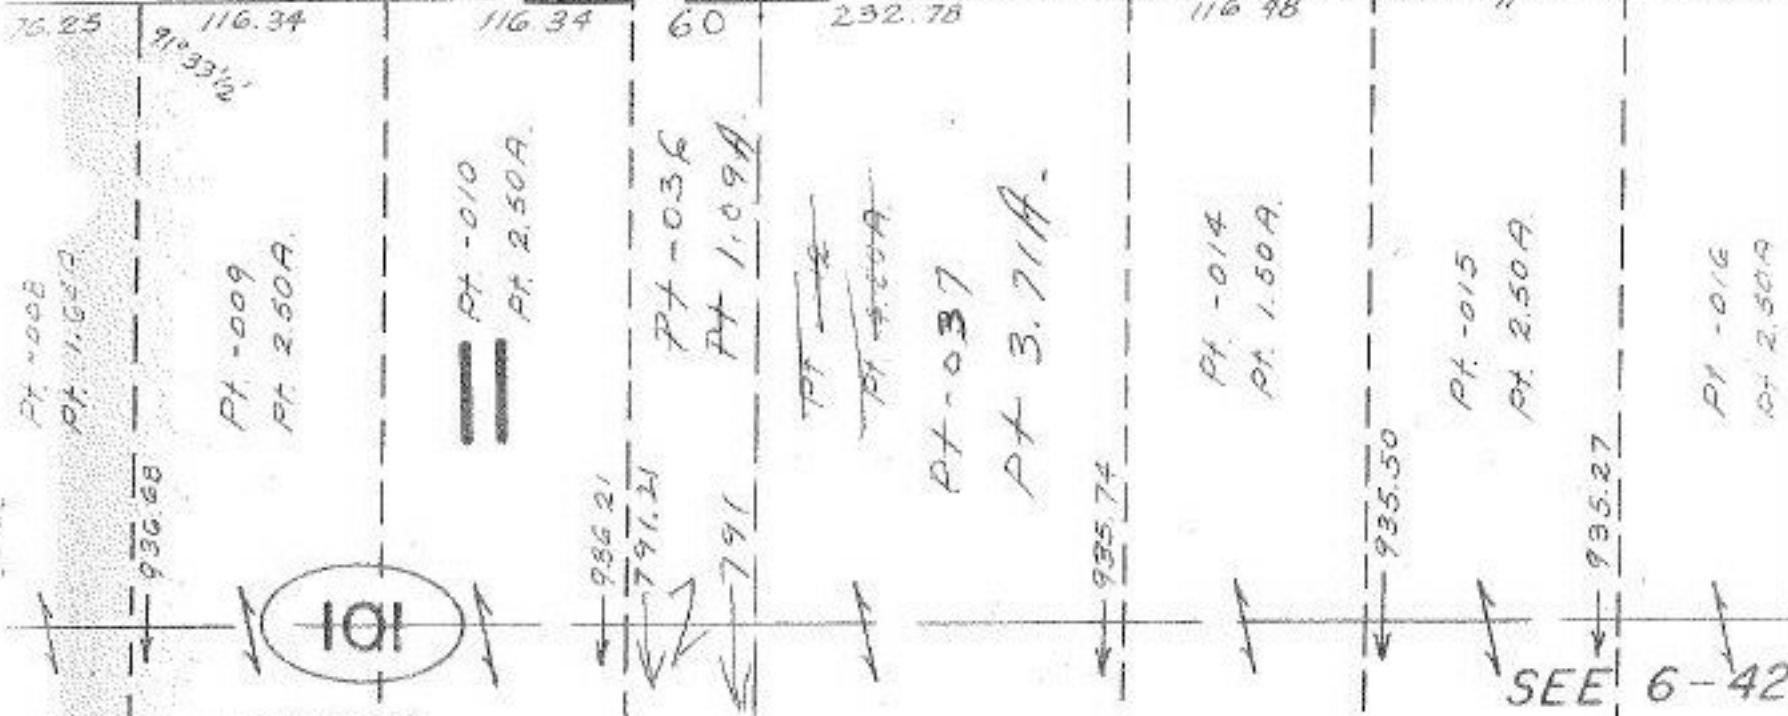

1756  
APPROVED  
LORAIN CO.  
MAP DEPT.  
DATE 5-13-68  
6-24  
BY D. Maynard

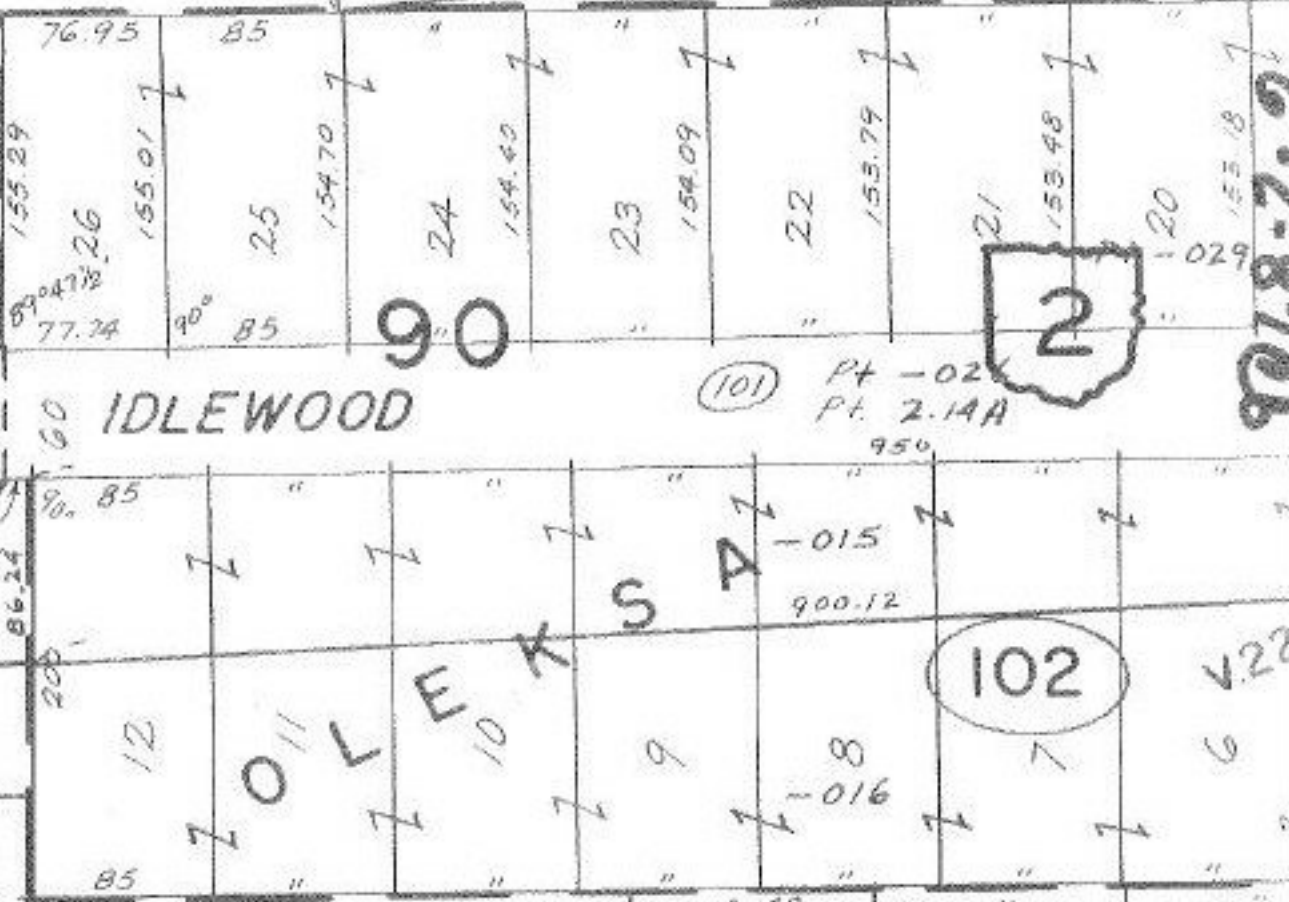

BRACE TRACT

W ly PT. LO  
NW ly PT. LO

232.78  
60  
172.78

Done 7-20-68  
[Signature]

9079-2-67