

LEAR NAGLE 943.17


-069
24.26 A.

SURVEYED BY CARY PENFOLD
CL. 1:166,666
(NO MAP PROVIDED - NAME ON DEED ONLY)

812.93
813

#17560

APPROVED
LORAIN CO.
MAP DEPT.
DATE 7/28/87
PAGE 4 00-026-E
BY T. McMain
VOID AFTER

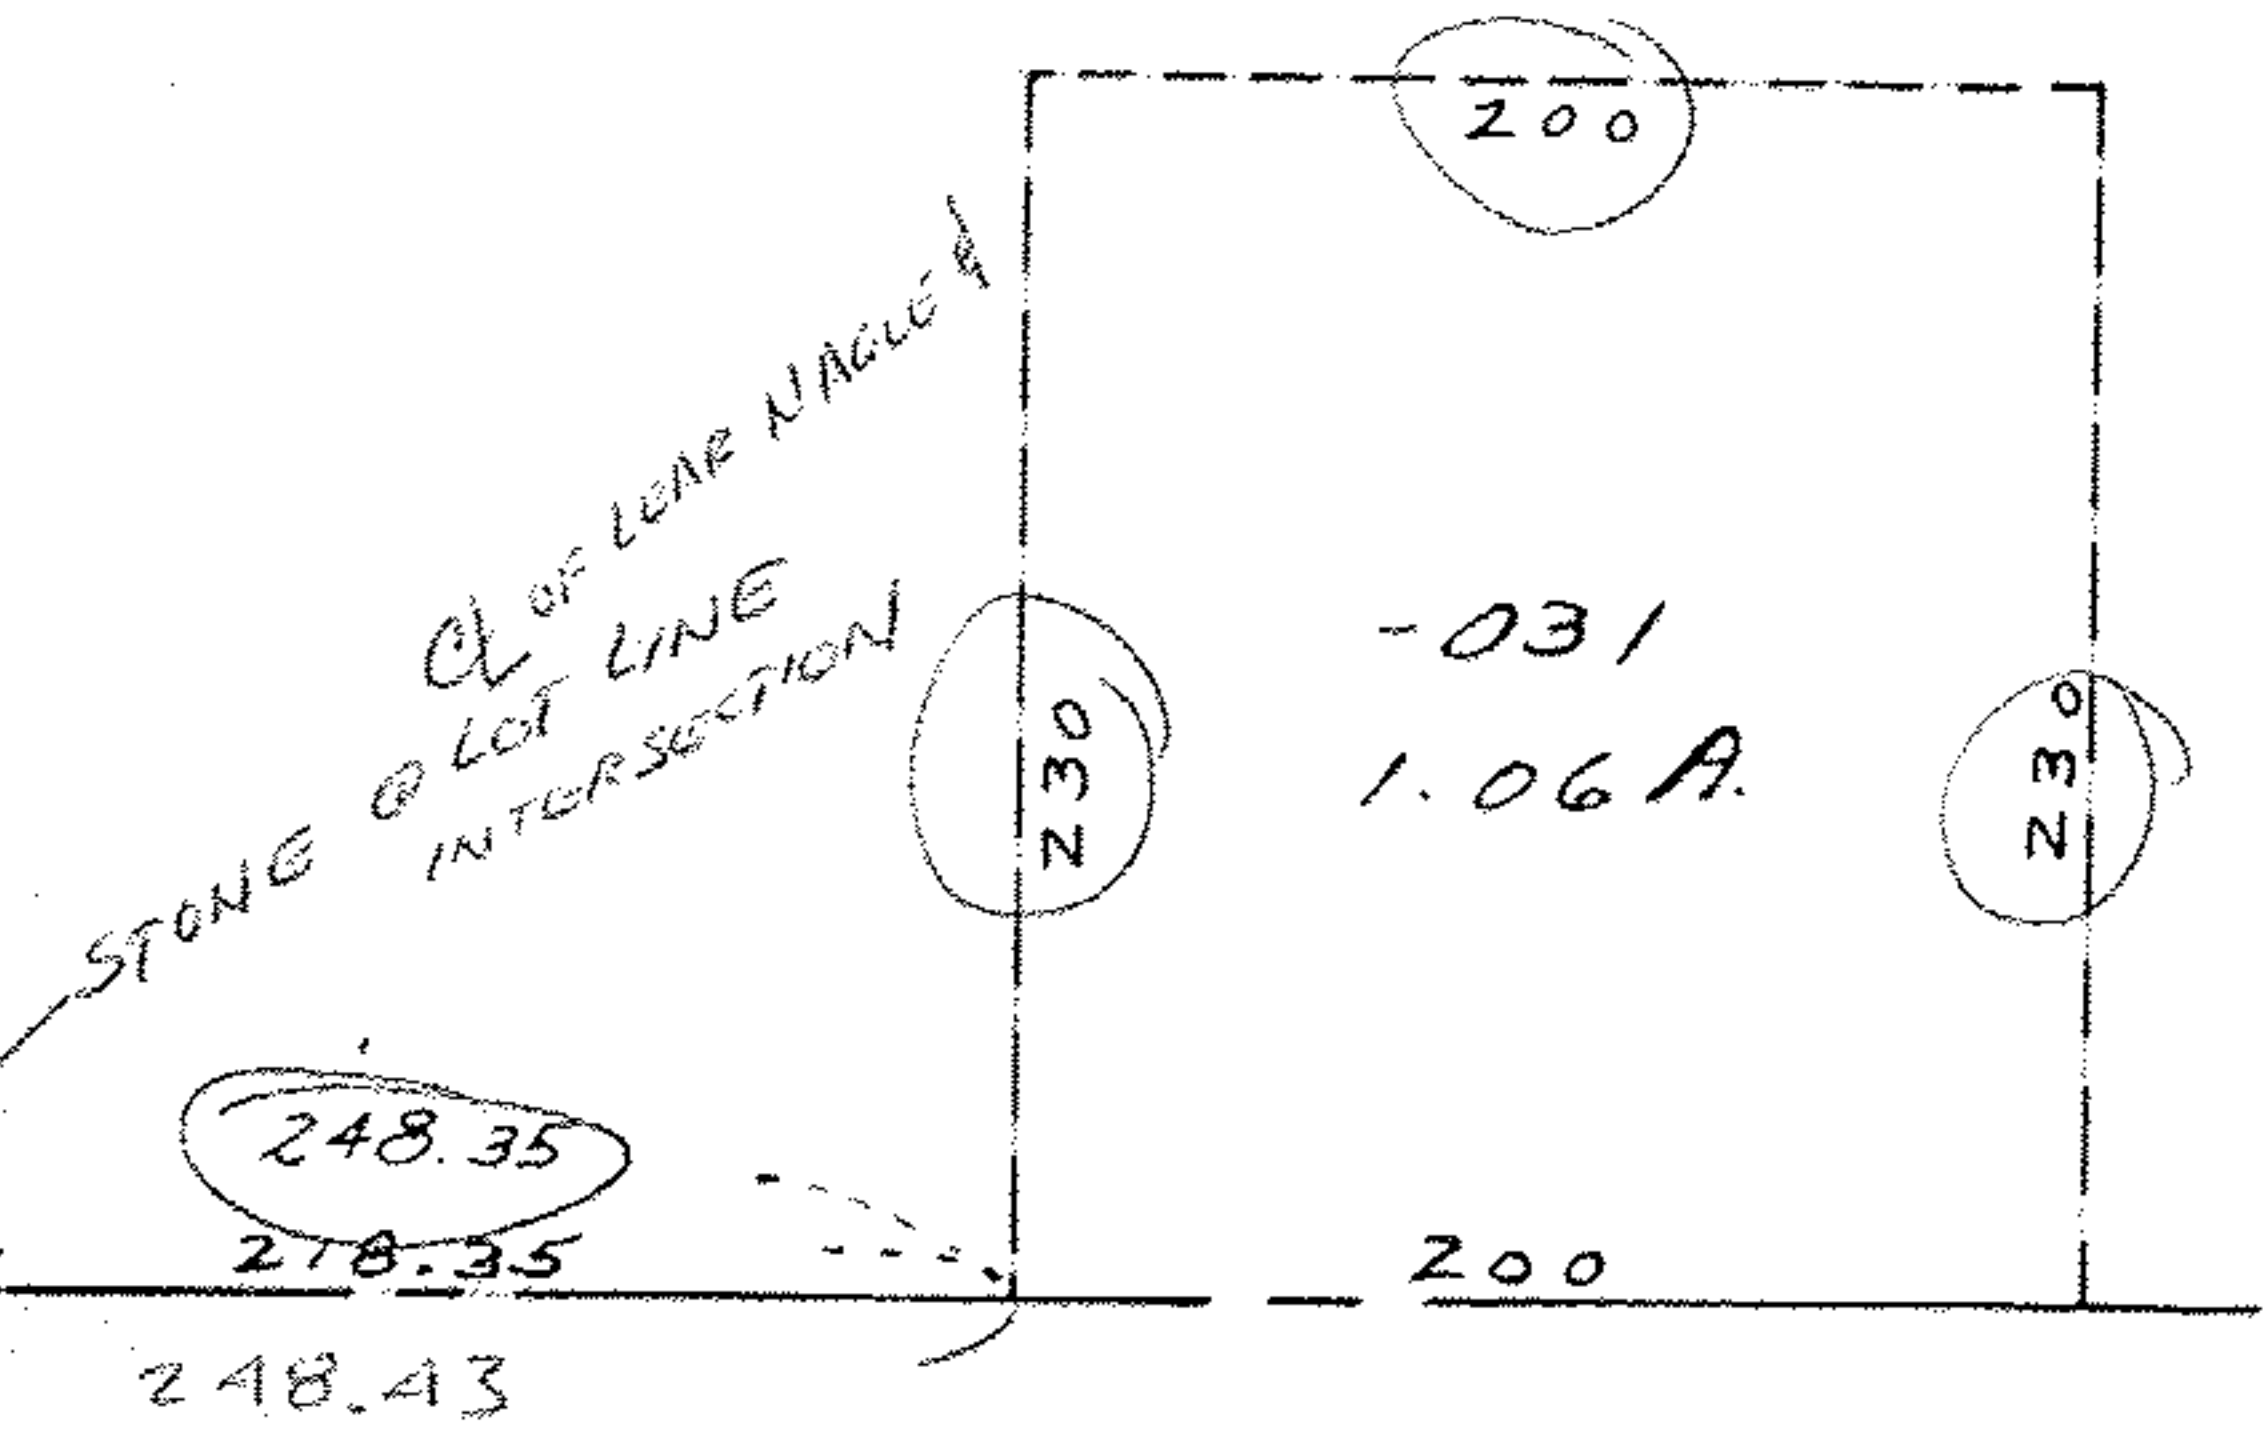

SN 10-29-87
#17560
APPROVED
LORAIN CO.
MAP DEPT.
DATE 7/28/87
PAGE 4 00-026-E
BY T. McMain
VOID AFTER

SEE 4-00-025-A