


SEE

SEE 5

DO NOT PUT DETAIL ON MAP - USE FOR DETERMINING OF DIMENSIONS ONLY

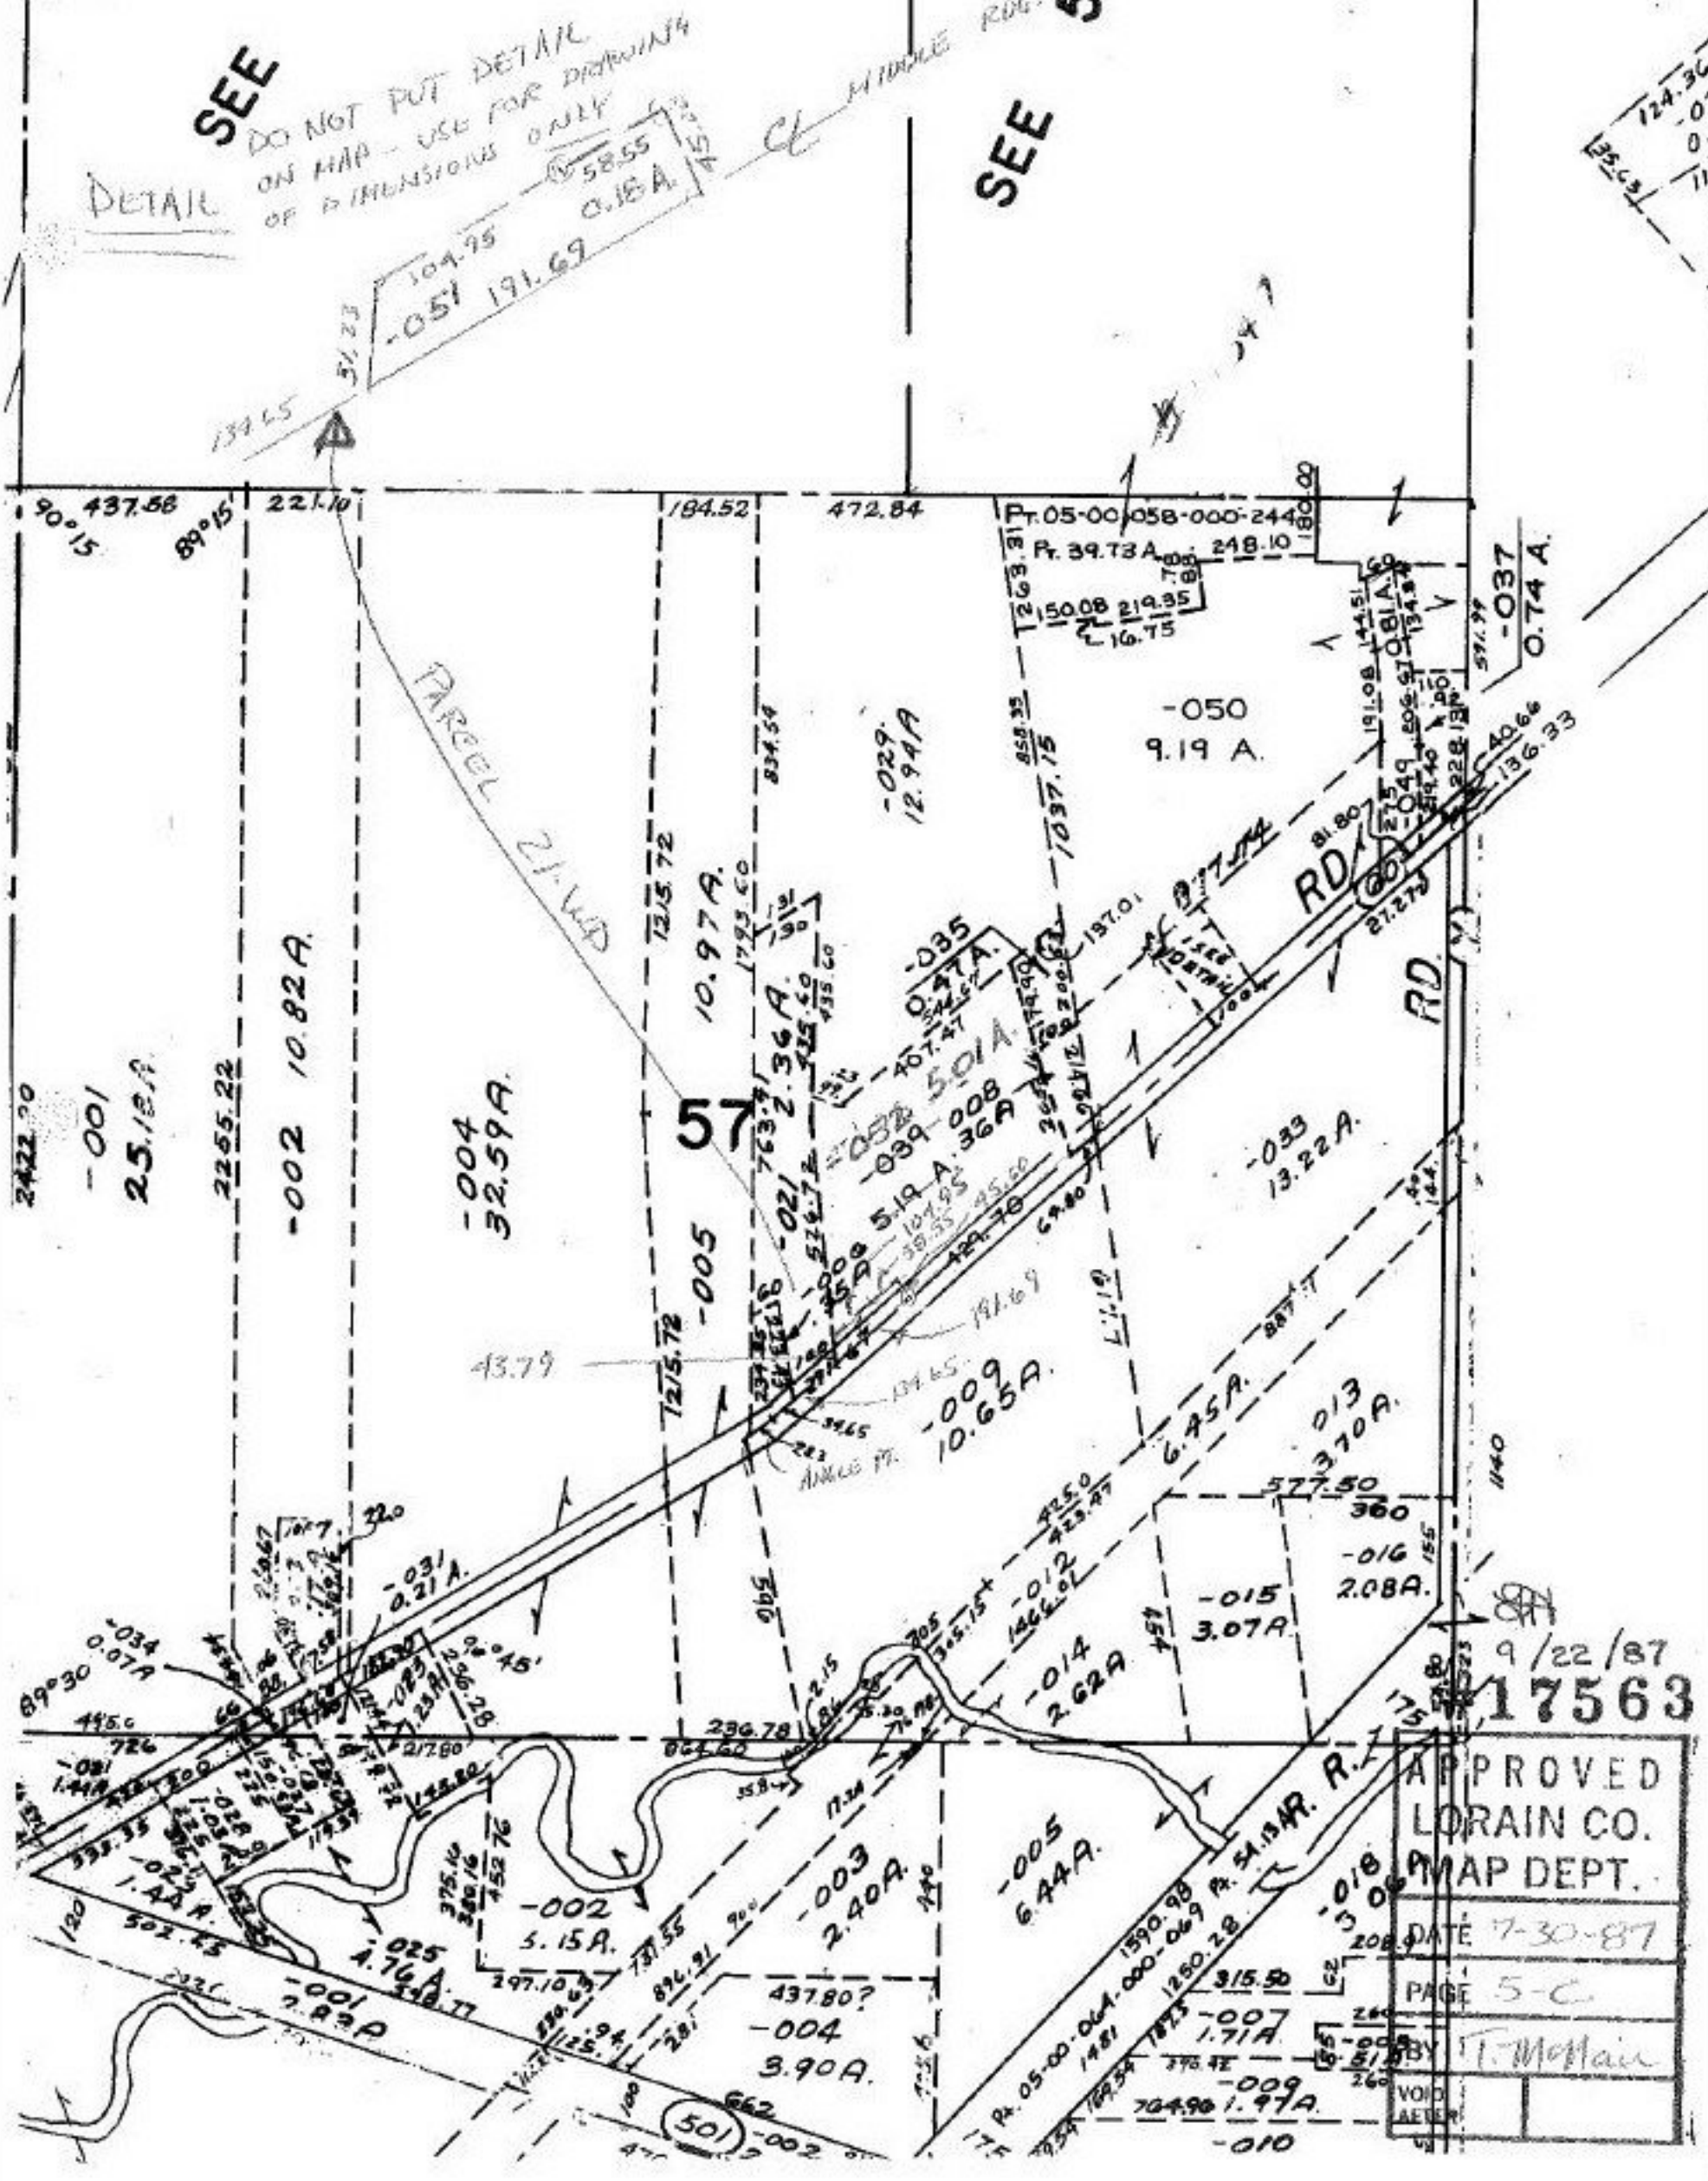

9/22/87
17563
 APPROVED
 LORAIN CO.
 MAP DEPT.
 DATE 7-30-87
 PAGE 5-C
 BY T. McMain
 VOID
 AFTER