


J MCKIN

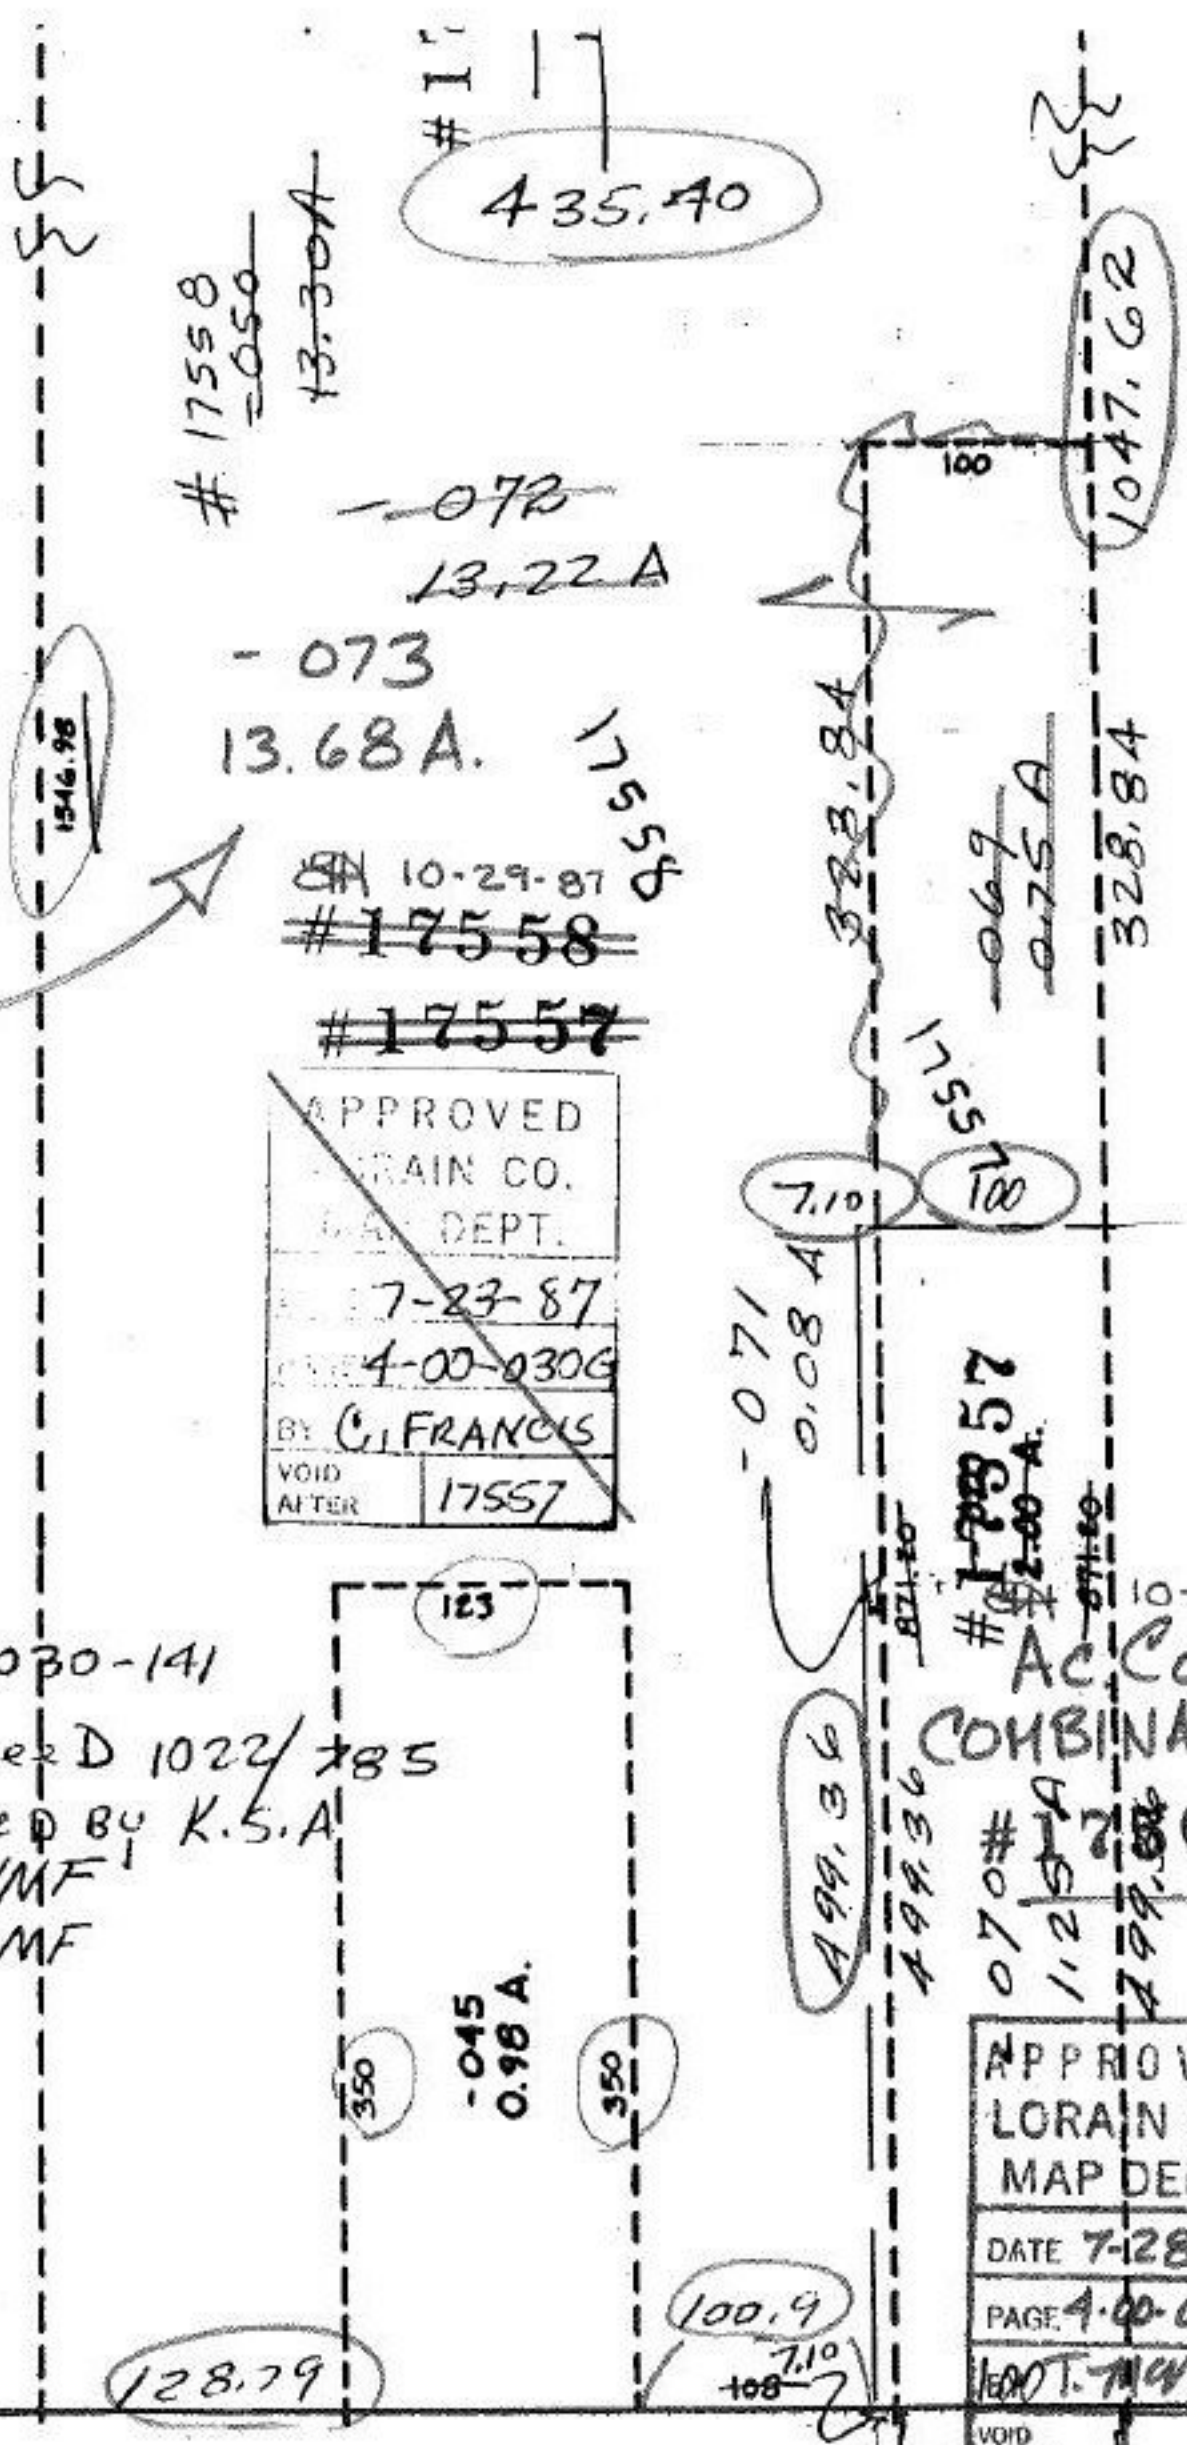

AC CORR. PER
SURVEY K.S.A.
CL.

4-00-030-141
Prior Dec D 1022/785
Surveyed by K.S.A.
(1) C=1:1MF
(2) 1:1MF

APPROVED
LORAIN CO.
MAP DEPT.
DATE 7-23-87
PAGE 4-00-030G
BY C. FRANCIS
VOID AFTER 17557

APPROVED
LORAIN CO.
MAP DEPT.
DATE 7-28-87
PAGE 4-00-030-G
T. McKinn
VOID AFTER 100

WALKER 123 108