

6

A.

01
00 A.

05

15
0 A.

3
A

60
84.46 CHS.

11.44 CHS.

Pt. -005
Pt. 75.75 A.

6

RD. (X)

65.94 CHS.

PT. 1

1784.48

T


Pt. -001
Pt. 67.22 A.

PT. 2

C


14.84 CHS.

38.85 CHS.

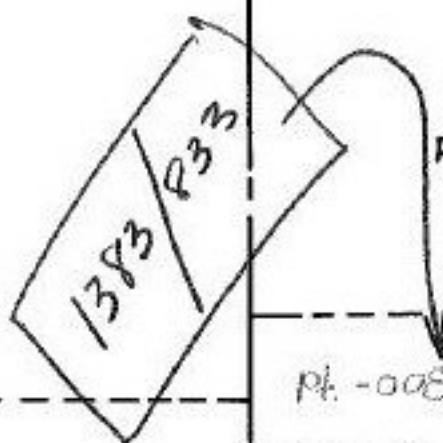


Pt. -006
Pt. 32.95 A.

PT. 3

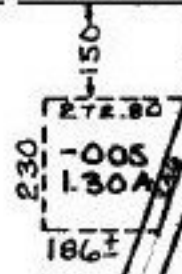

Pt. -008

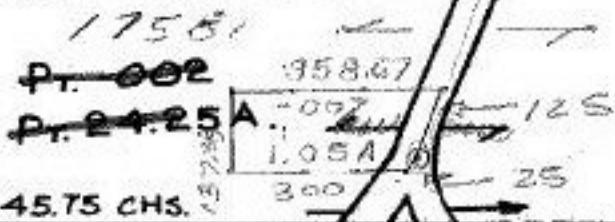

19-06-003-000

PRIOR Deed

Surveyed By:

15.25 CHS.

1383-883


John Pozzani
Reg. Surveyor

Pt. -003
Pt. 62.60 A.

PT. 4

9/30/87
17581

APPROVED
LORAIN CO.
MAP DEPT.
DATE 8-2-87
PAGE 19-C
BY C. FRANCIS
VOID AFTER 17581

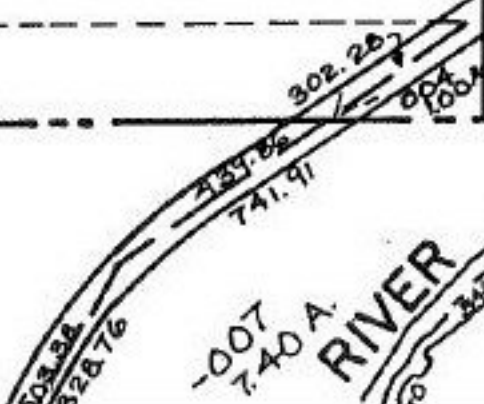

-007
7.40 A.

RIVER

2292.18

PT. 30