

EMERALD

02-02-004-900-003

DR.

3.38 A.

DRIVE

DRIVE

DRIVE

WESTWOOD DRIVE

#1760

APPROVED  
 LORAIN CO.  
 MAP DEPT.  
 DATE 5-14-68  
 2-02-004-B  
 BY *D. Maynes*

SUB. PG. 48-008

104

110

EVEN


VOL. SEVEN VOL.

DRIVE PINES

24

PINES

Date 7-6-68

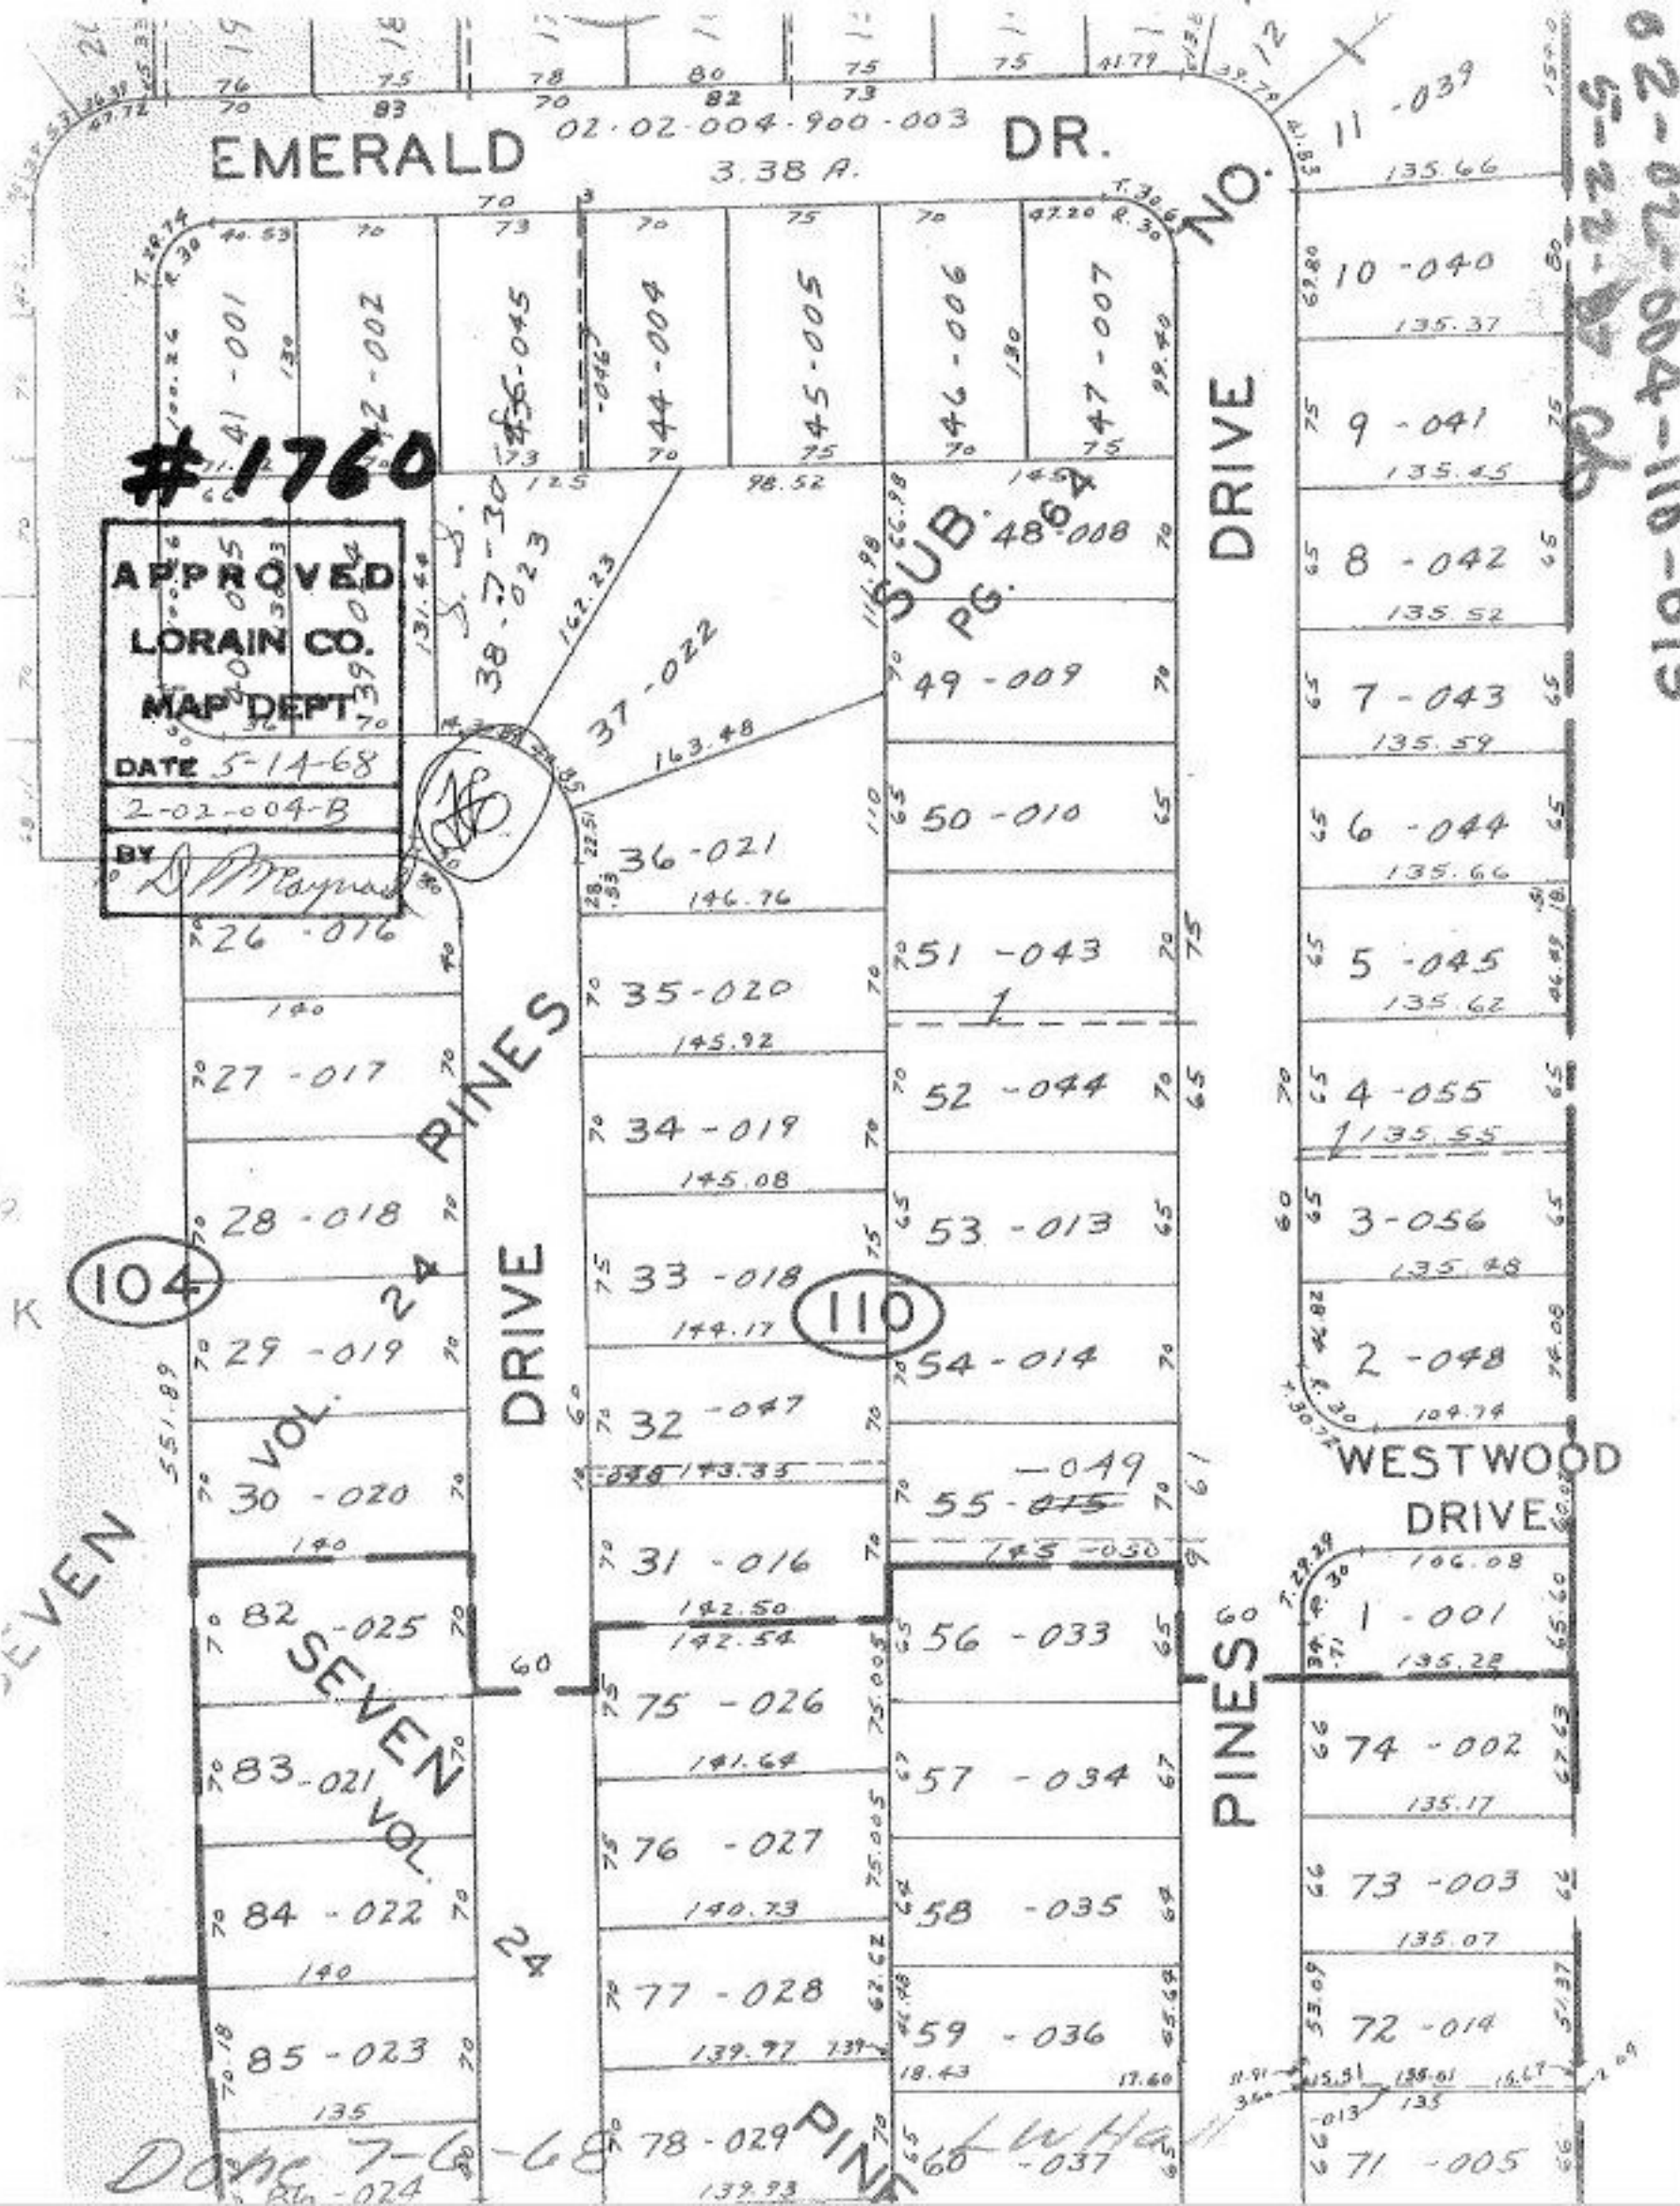

02-02-004-110-015  
05-22-65