


VOID
10-30-87
[Signature]

Ac. per Dec Ds
SEE # 17645 FOR Deletion; Ac. CORN.

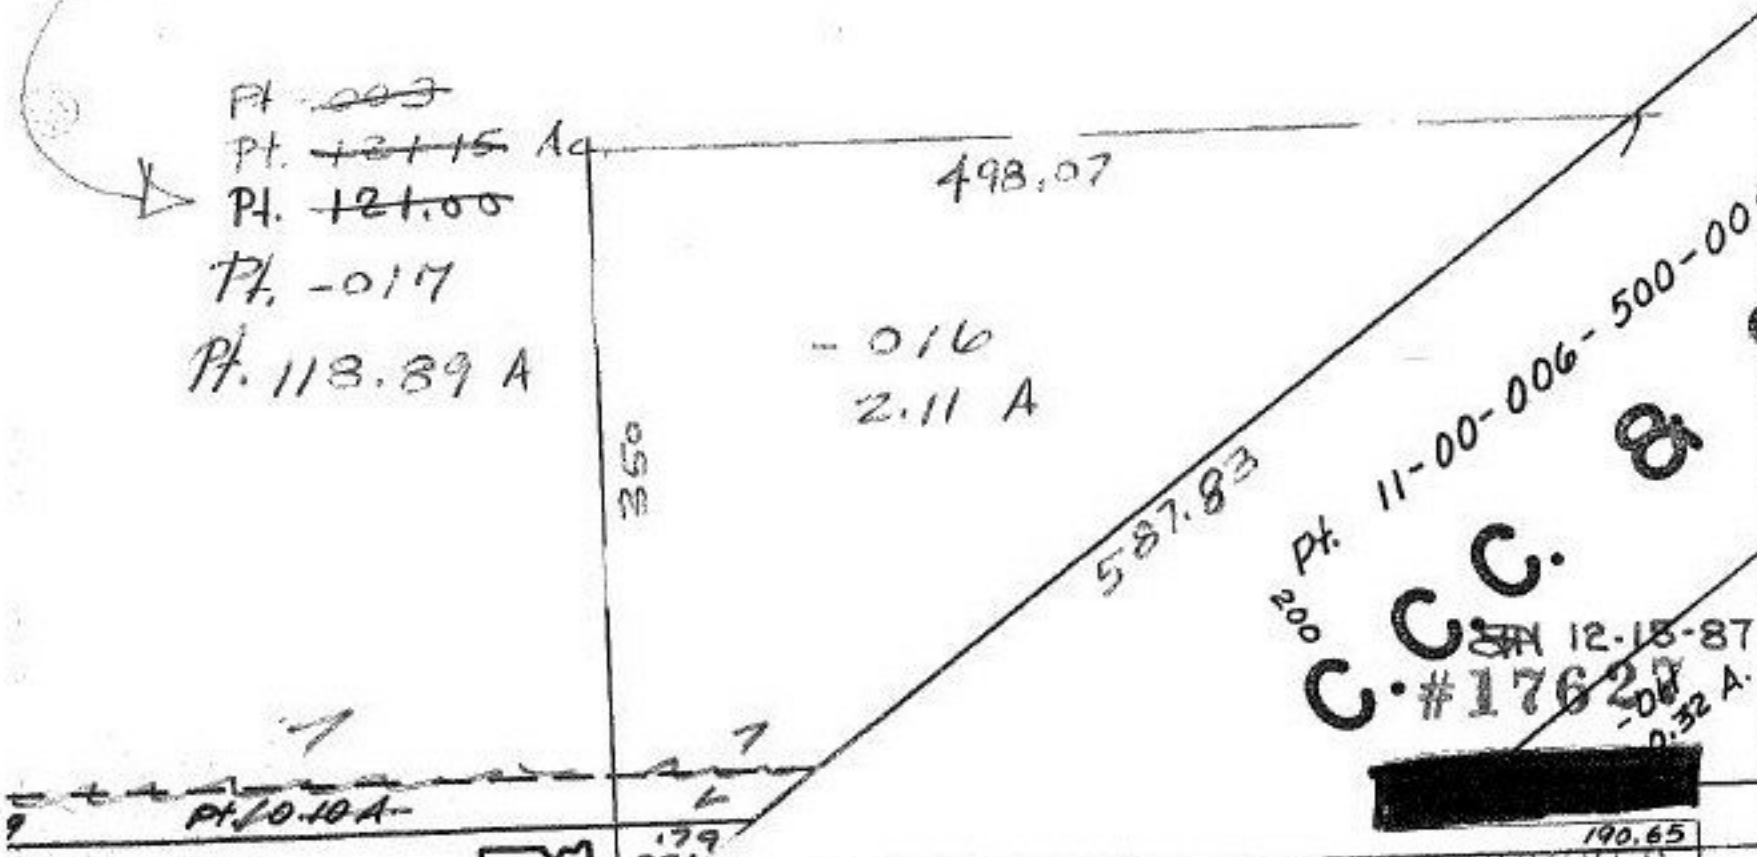

Pt. 11-00-006-500-001
C.C.C.
12-18-87
#17628
0-32 A.

VSBURG — 82

SEE 11-00-016-B

APPROVED	ORAIN CO.
MAP DEPT.	
DATE	9-2-87
PAGE	11-00-015-B
BY	C. Francis
VOID AFTER	17645