
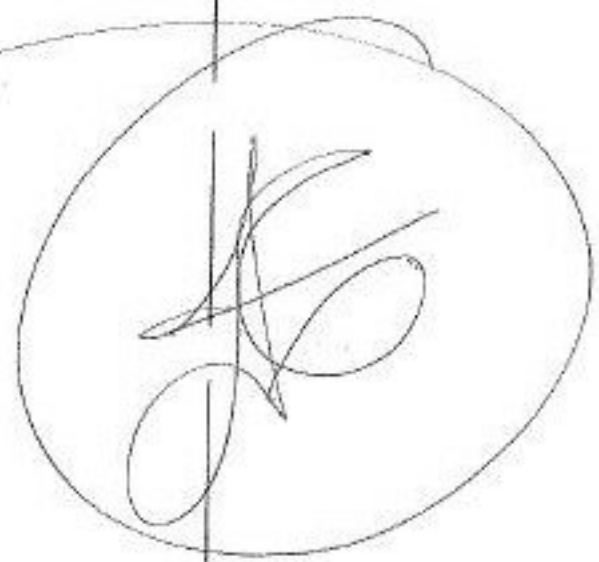


1763

11-30-68-11  
JK

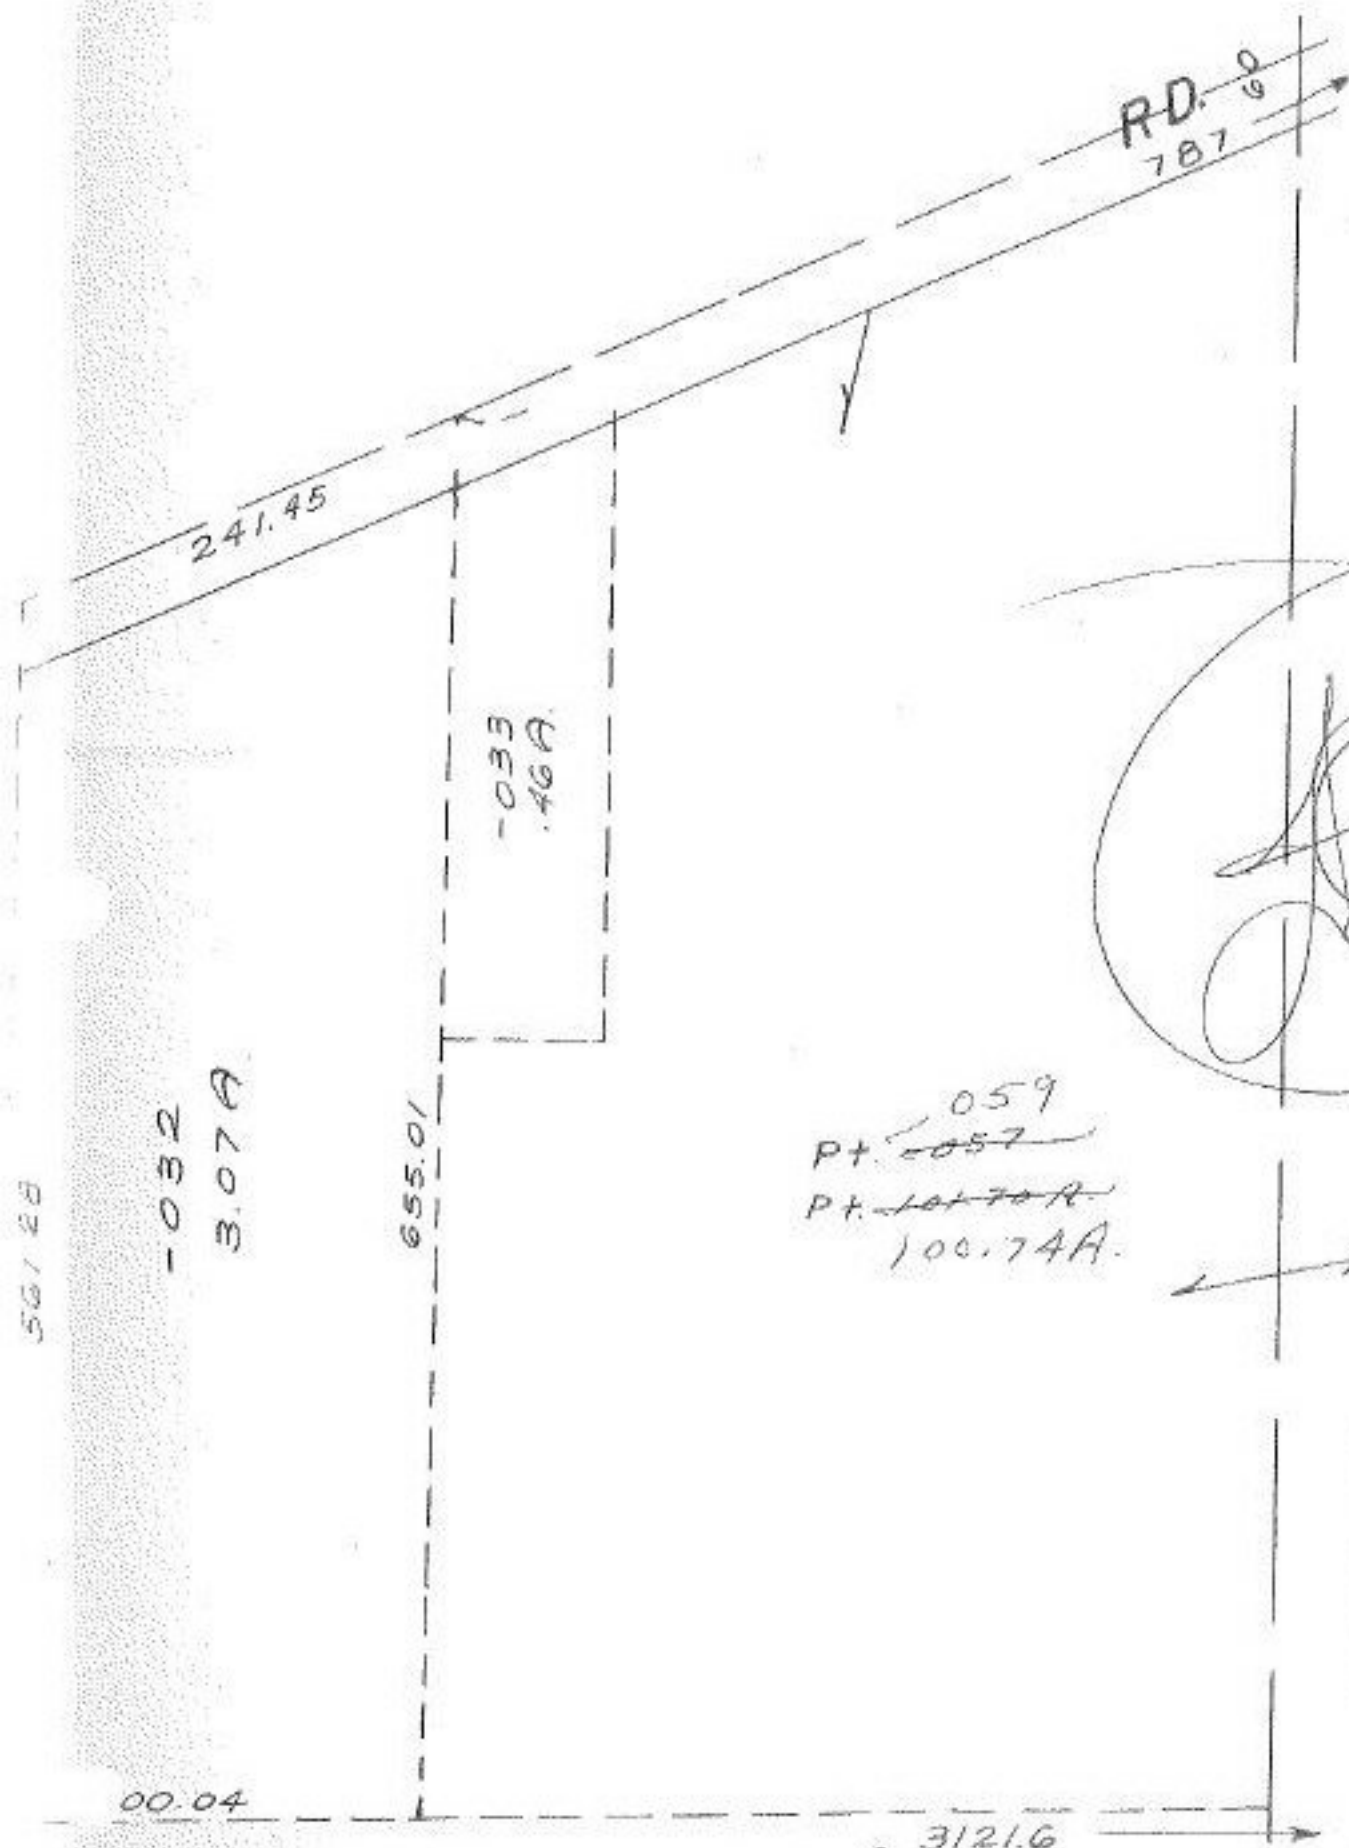

#1763
APPROVED
LORAIN CO.
MAP DEPT.
DATE 5-15-68
7-00-038-C
BY D. Maynard

DONE 7/8/68

W. Kochis