


VALLEY

115 -048

VOL. 41

116 -049

SEE 5-00-005-A

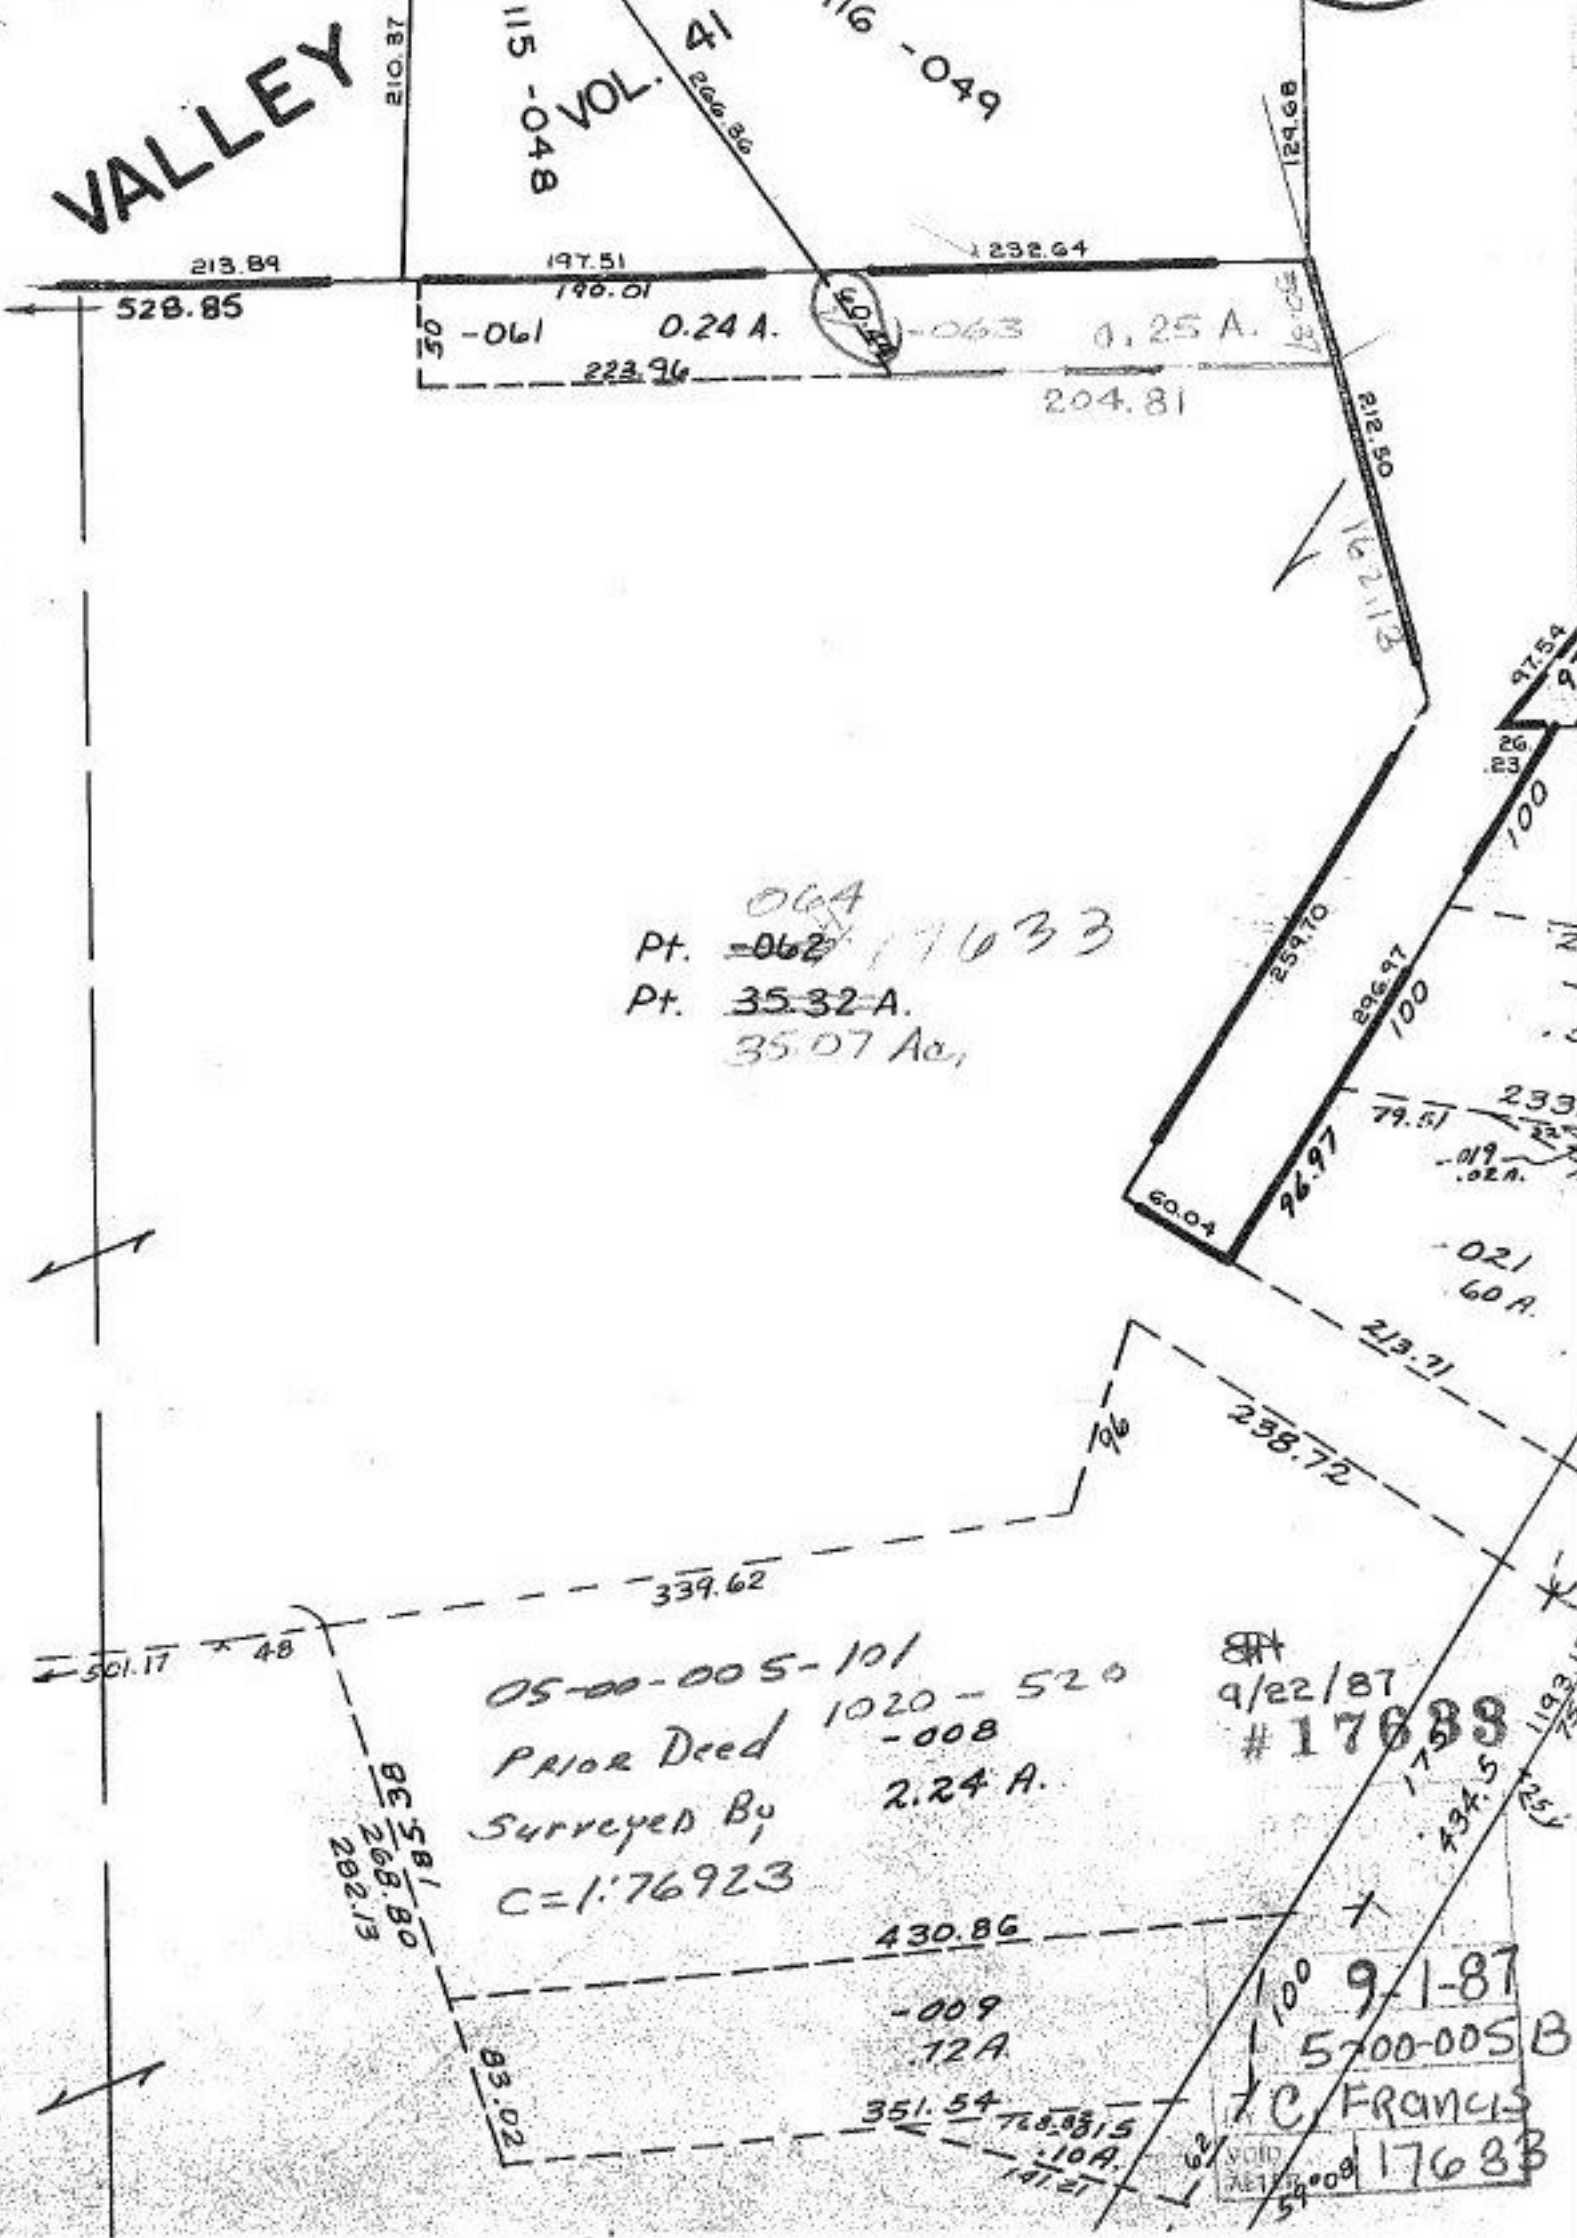

213.89
528.85

210.87

197.51
198.01

232.64

05-061 0.24 A. 063 0.25 A.
223.96 204.81

129.68

212.50

162.13

97.54

26.83

100

Pt. 064
Pt. ~~062~~ 17633
Pt. 35-32 A.
35.07 Ac.

259.70

296.97

100

60.04

96.97

79.51

233.22

109.02 A.

021
60 A.

213.71

96

238.72

339.62

501.17 x 48

05-00-005-101
Prior Deed 1020-520-008
Surveyed By
C=1:76923

9/22/87
#17633

BE 581
268.80
282.13

430.86

009
72 A.

83.02

351.54

728.8315
10 A.

9-1-87
5-00-005B
C FRANCIS
17633

59.00

17633