


SEE 10-00-006-D

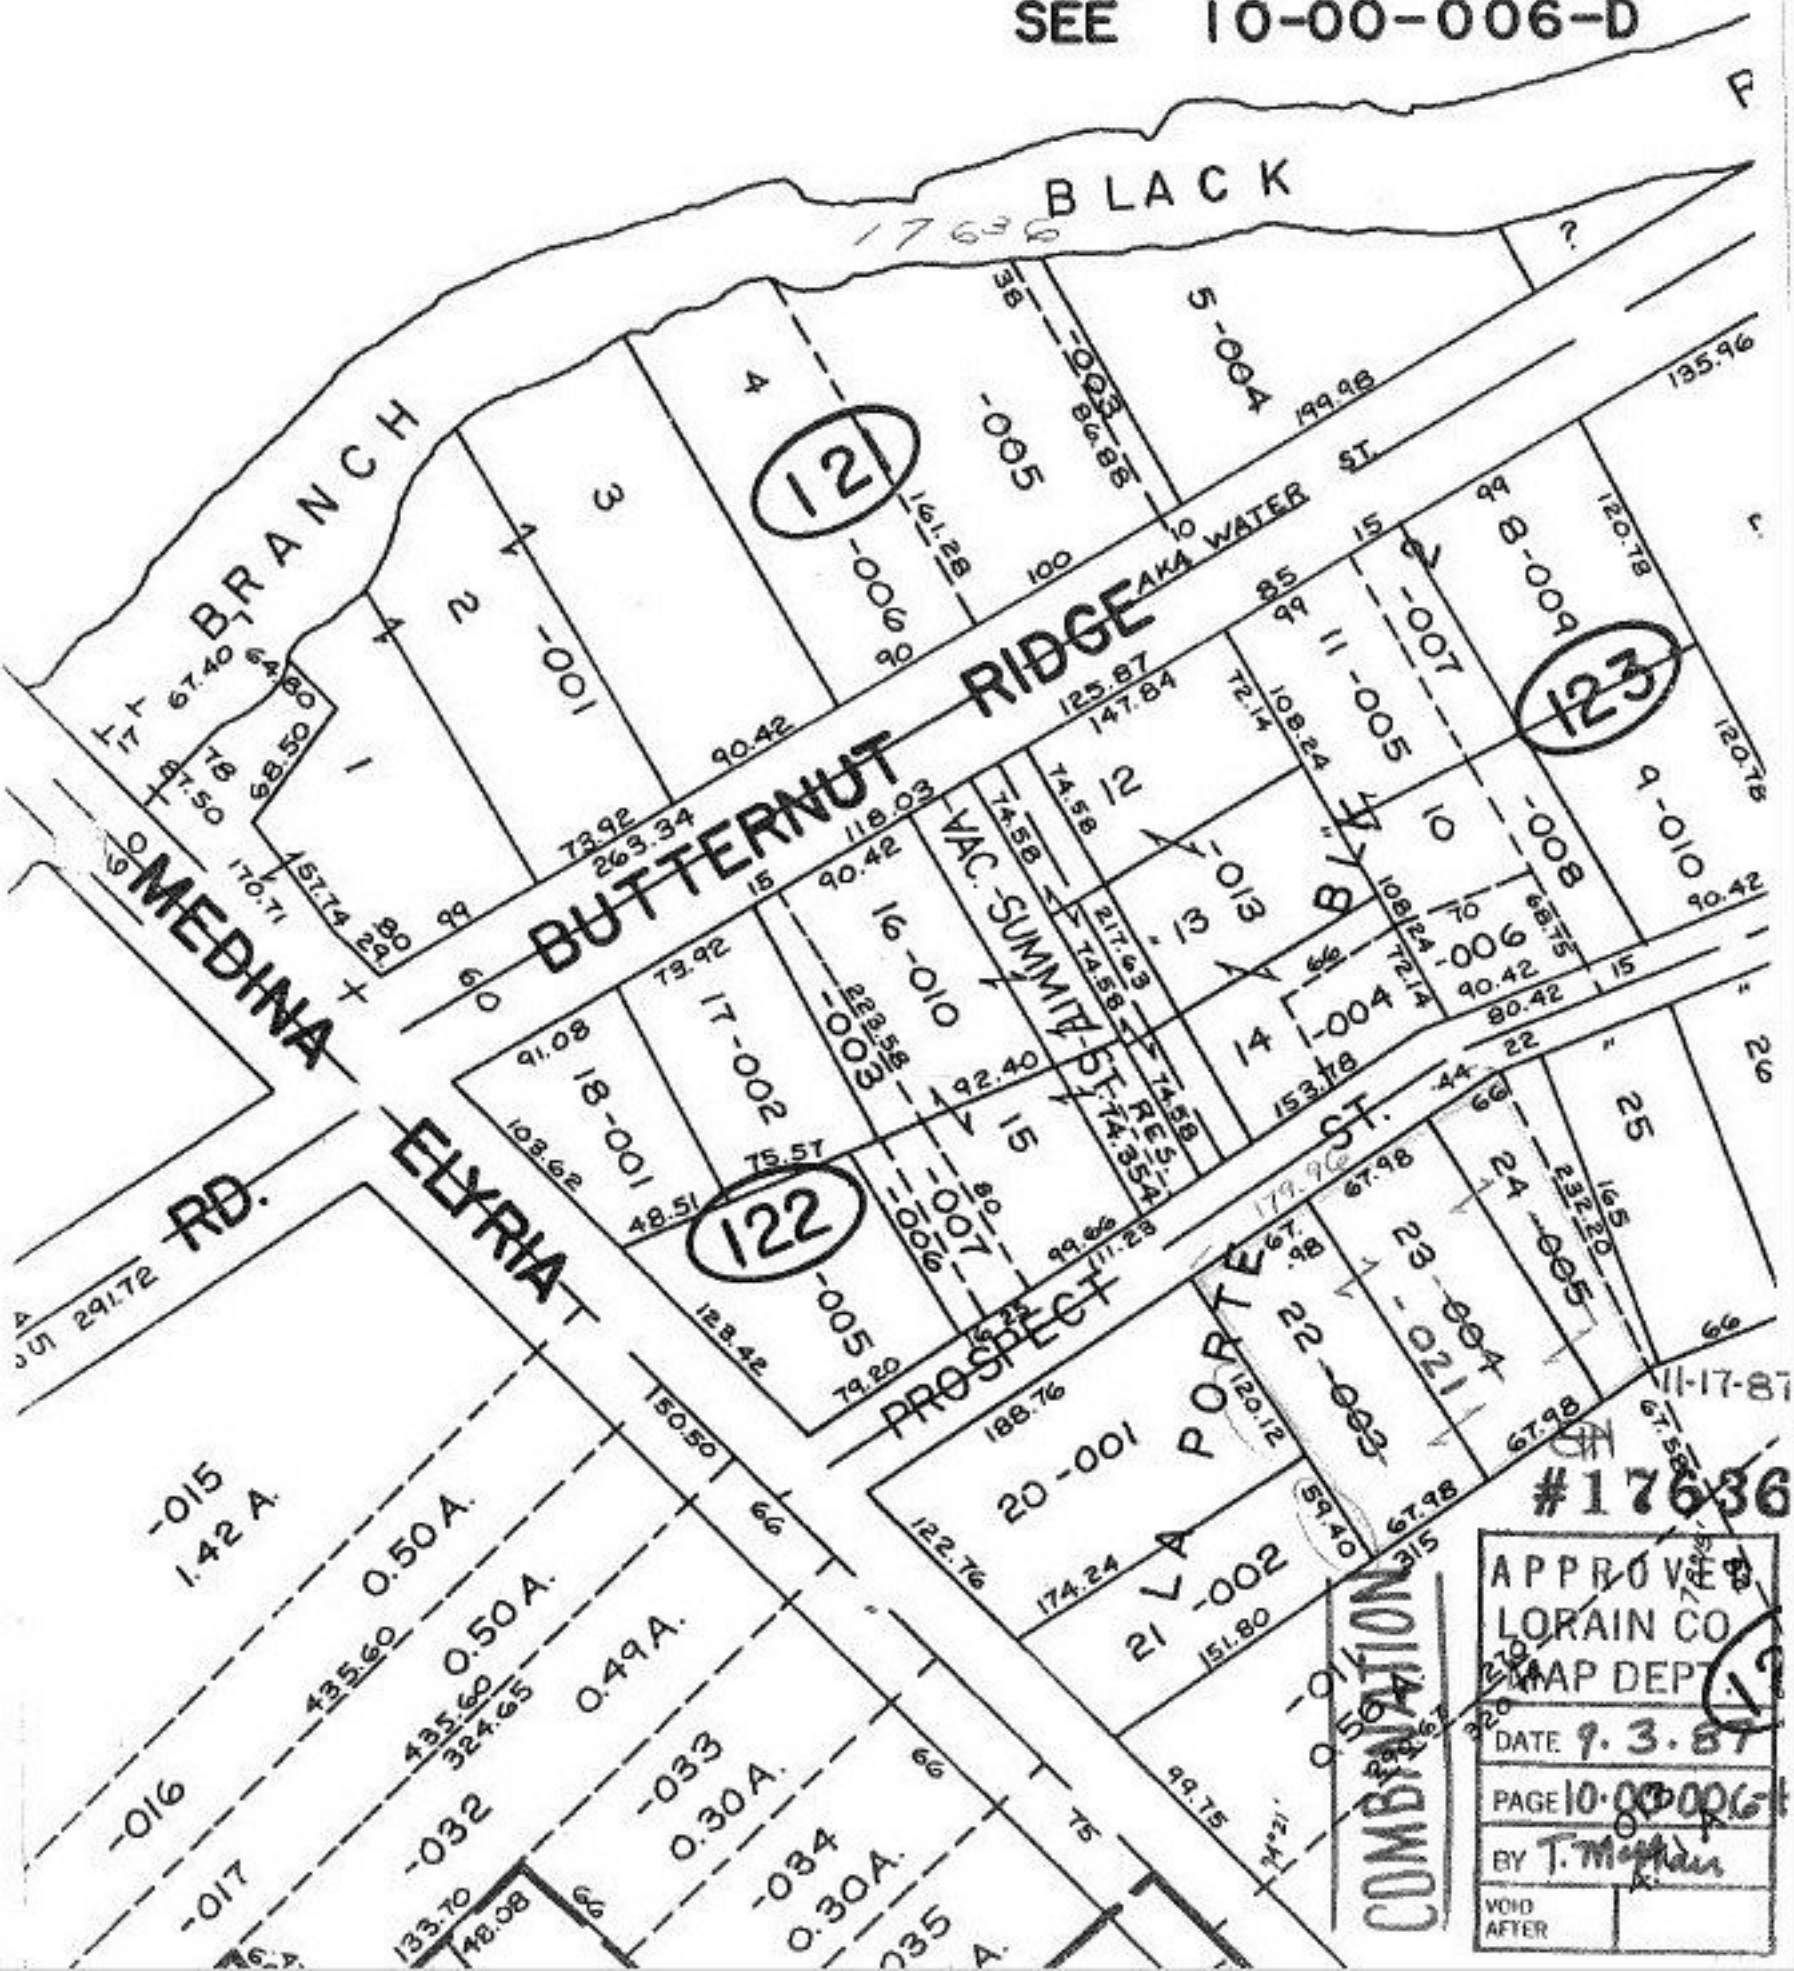

#17636

APPROVED
 LORAIN CO
 MAP DEPT.
 DATE 9.3.87
 PAGE 10-00-006-D
 BY T. McPherson
 VOID AFTER

COMBINATION