


SEE 7-

1367 To E Mills Rd
-1250.16 TO
72.9

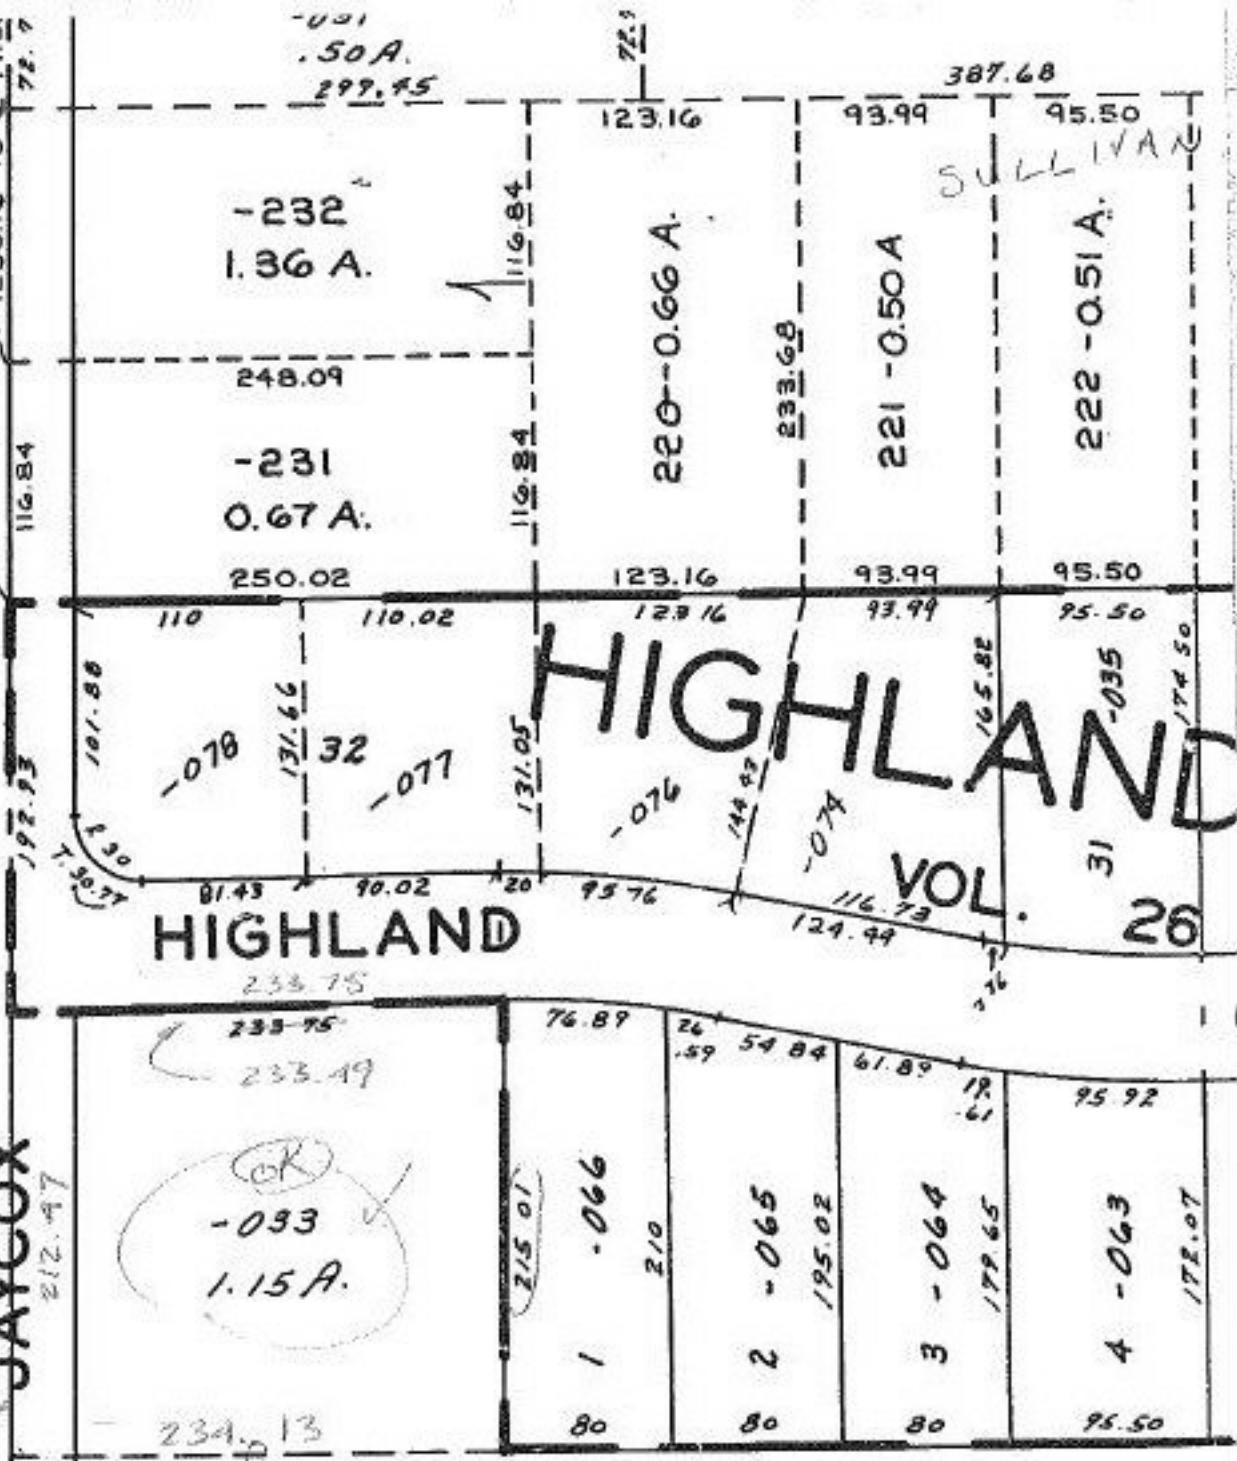

HIGHLAND

HIGHLAND
VOL. 26

JAYCOX

OK
-093
1.15 A.

RESULT OF J. R. FORD & Assoc. SURVEY
(NO MAP/ SURVEYORS NAME ON ETC)
CL. 1: 66,666
#17638

DEED CHECK
MAP CORRECTION

APPROVED LORAIN CO. MAP DEPT.
DATE 9-1-87
BY T. McMain
VOID AFTER

REVISED 6-8-87

7-00-018-A

NW 1/4

LOT 18