


SEE 5-00-04

48

SEE 5-00-042

SEE 5-00-053

LAN - ELYRIA  
(66)

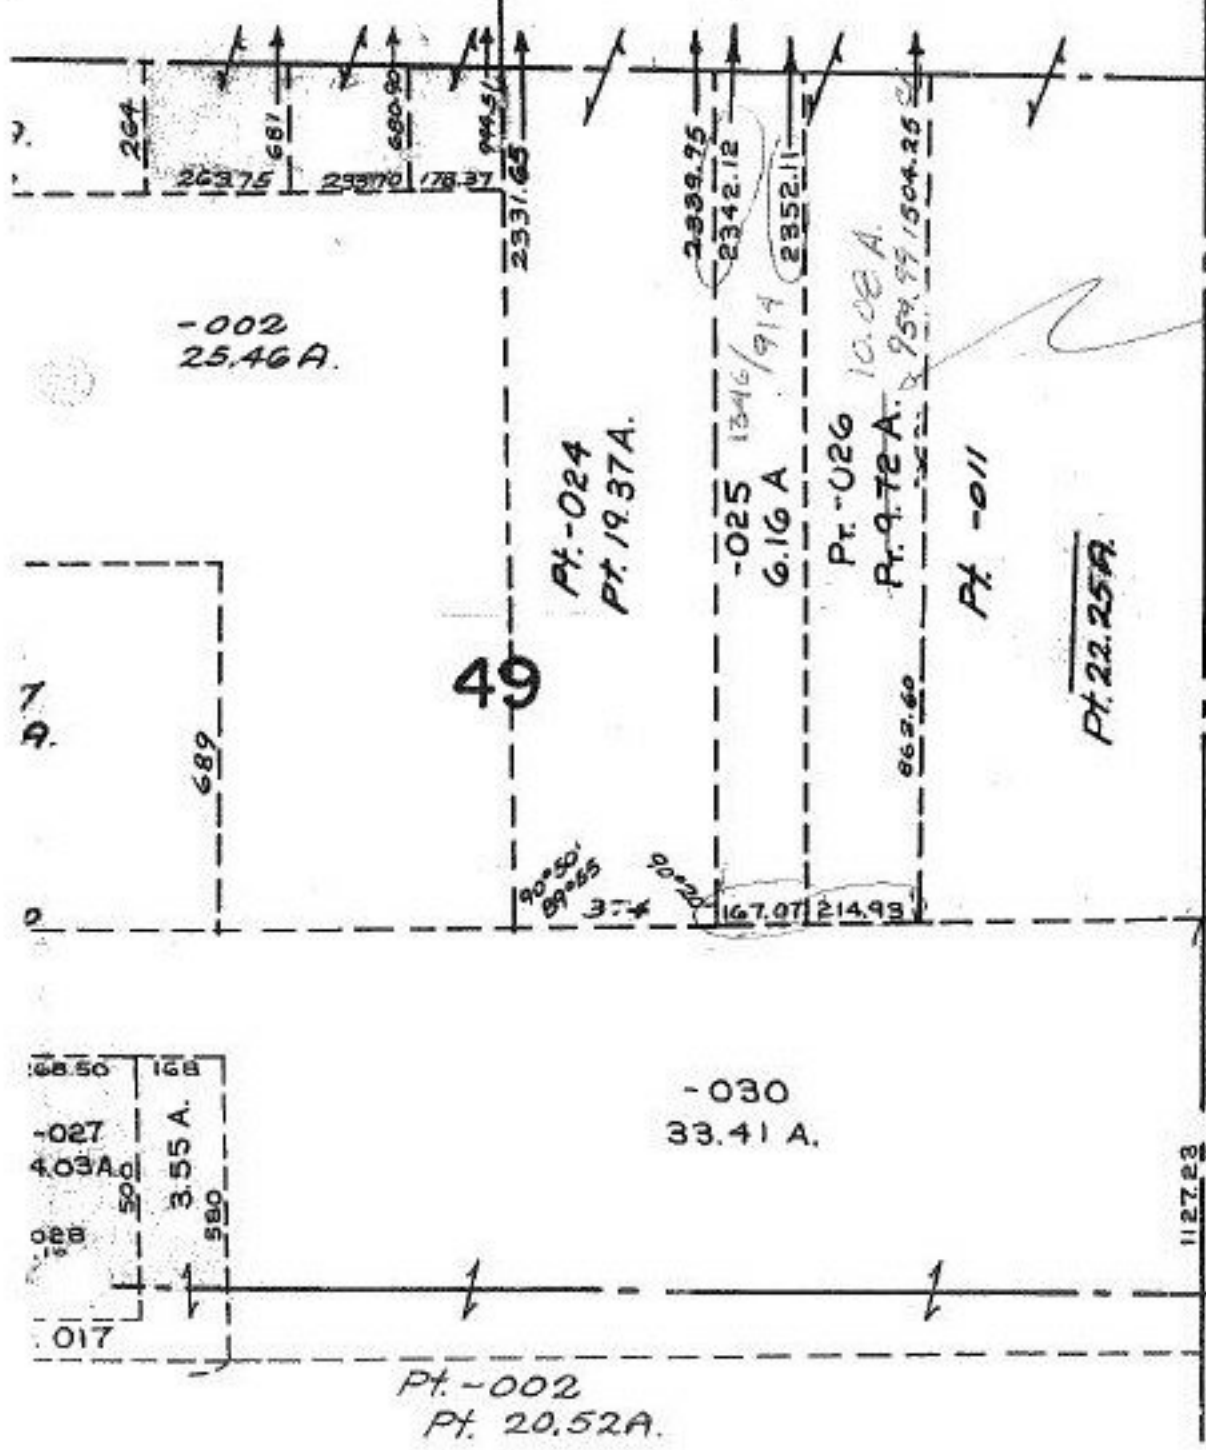

SUBMITTED BY  
 McGLINCHY & ASSOC.  
 CL. 1:333, 333  
 NO MAP - NAME ON DEED

SEE CORRECTION  
 #17642  
 5-00-052-A  
 9/22/87  
 ACRE.

APPROVED LORAIN CO. MAP DEPT.	
DATE 9-2-87	
PAGE 5-G	
BY T. McMain	
WRD AFTER	-001