


113

SEE 5-E

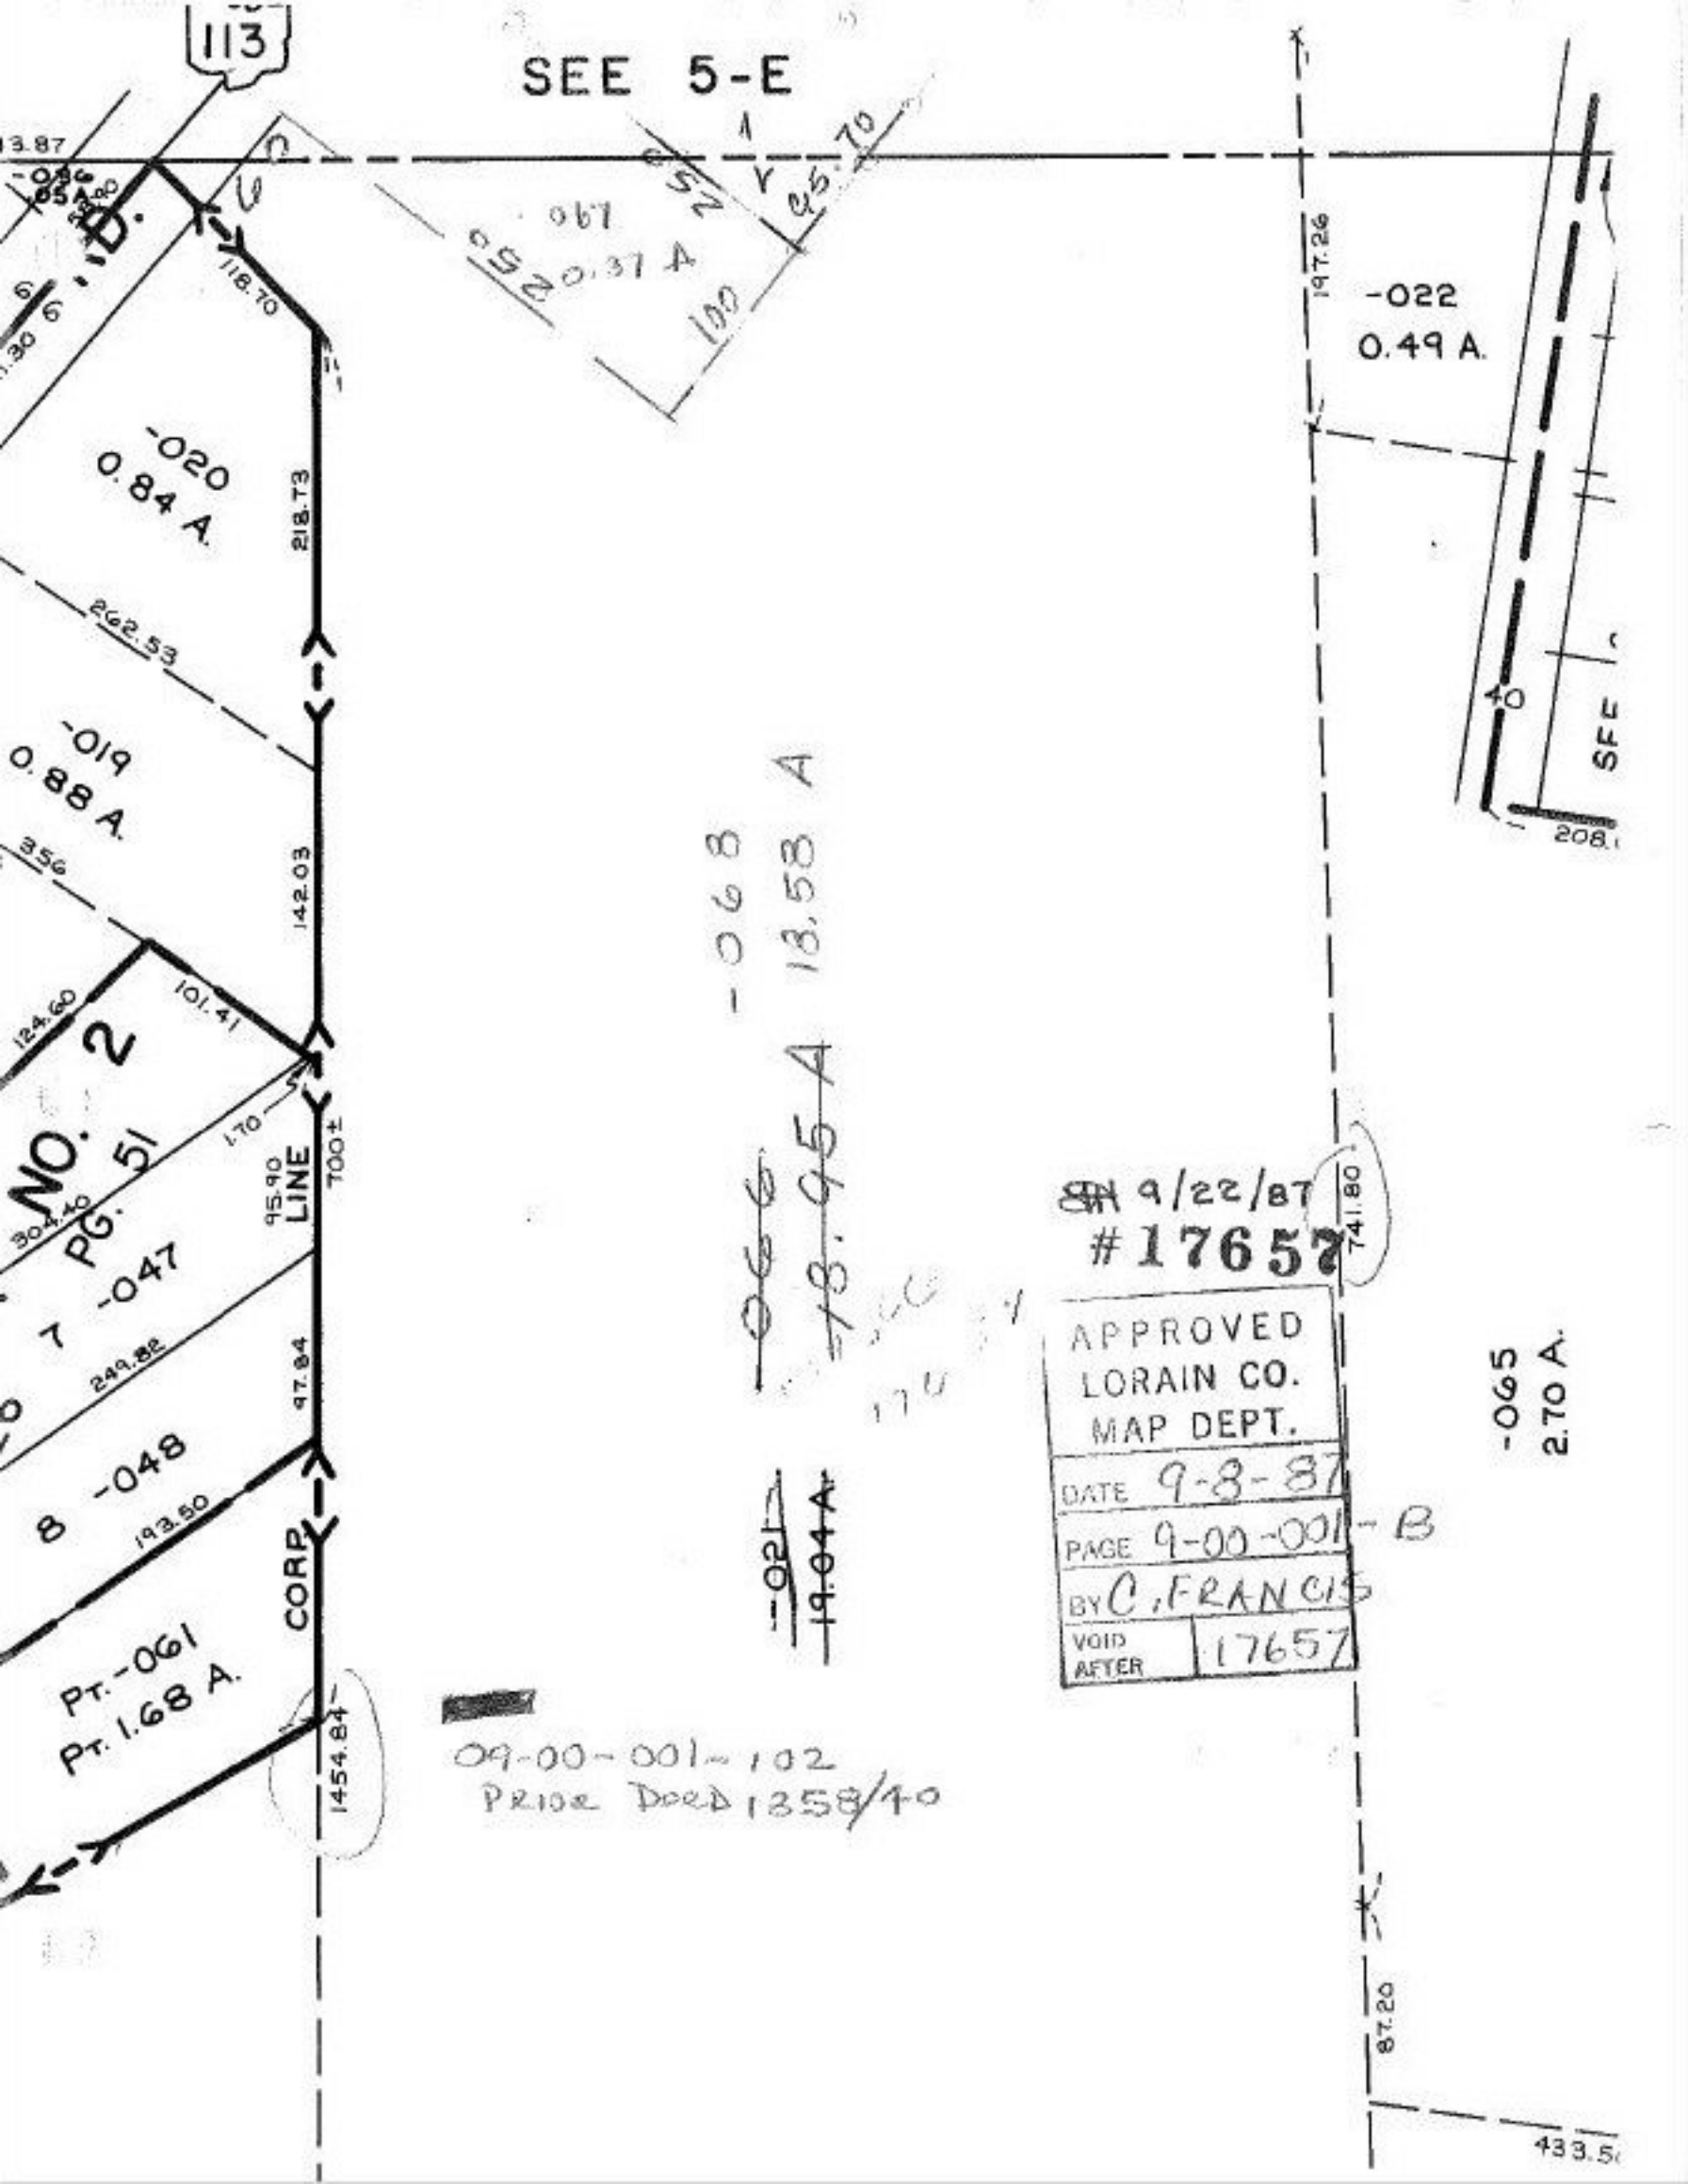

-020
0.84 A.

-019
0.88 A.

NO. 2
PG. 51

7 -047

8 -048

Pt. -061
Pt. 1.68 A.

CORP LINE

1454.84

09-00-001-102
PRIOR DEED 1358/70

-068
18.58 A

~~066~~
~~18.95 A~~

~~021~~
~~19.04 A~~

9/22/87
#17657

APPROVED LORAIN CO. MAP DEPT.	
DATE	9-8-87
PAGE	9-00-001-B
BY	C. FRANCIS
VOID AFTER	17657

-065
2.70 A.

-022
0.49 A.

SEE

433.5