


Pt. -032  
Pt. 14.62 A.

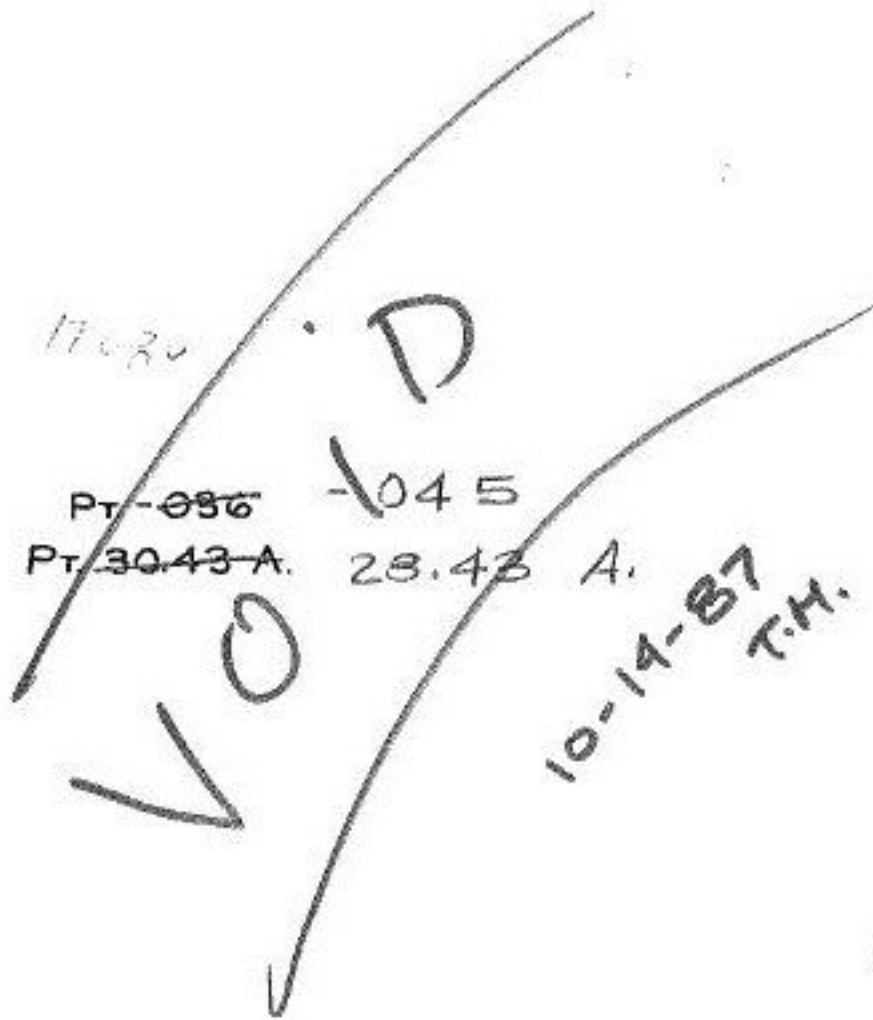

11-6-87  
#17686

SEE 9-A

APPROVED LORAIN CO. MAP DEPT.	
DATE 9-18-87	
PAGE 9-00-002-B	
BY C. FRANCIS	
VOID AFTER	17686