


SEE 7-00-019-B

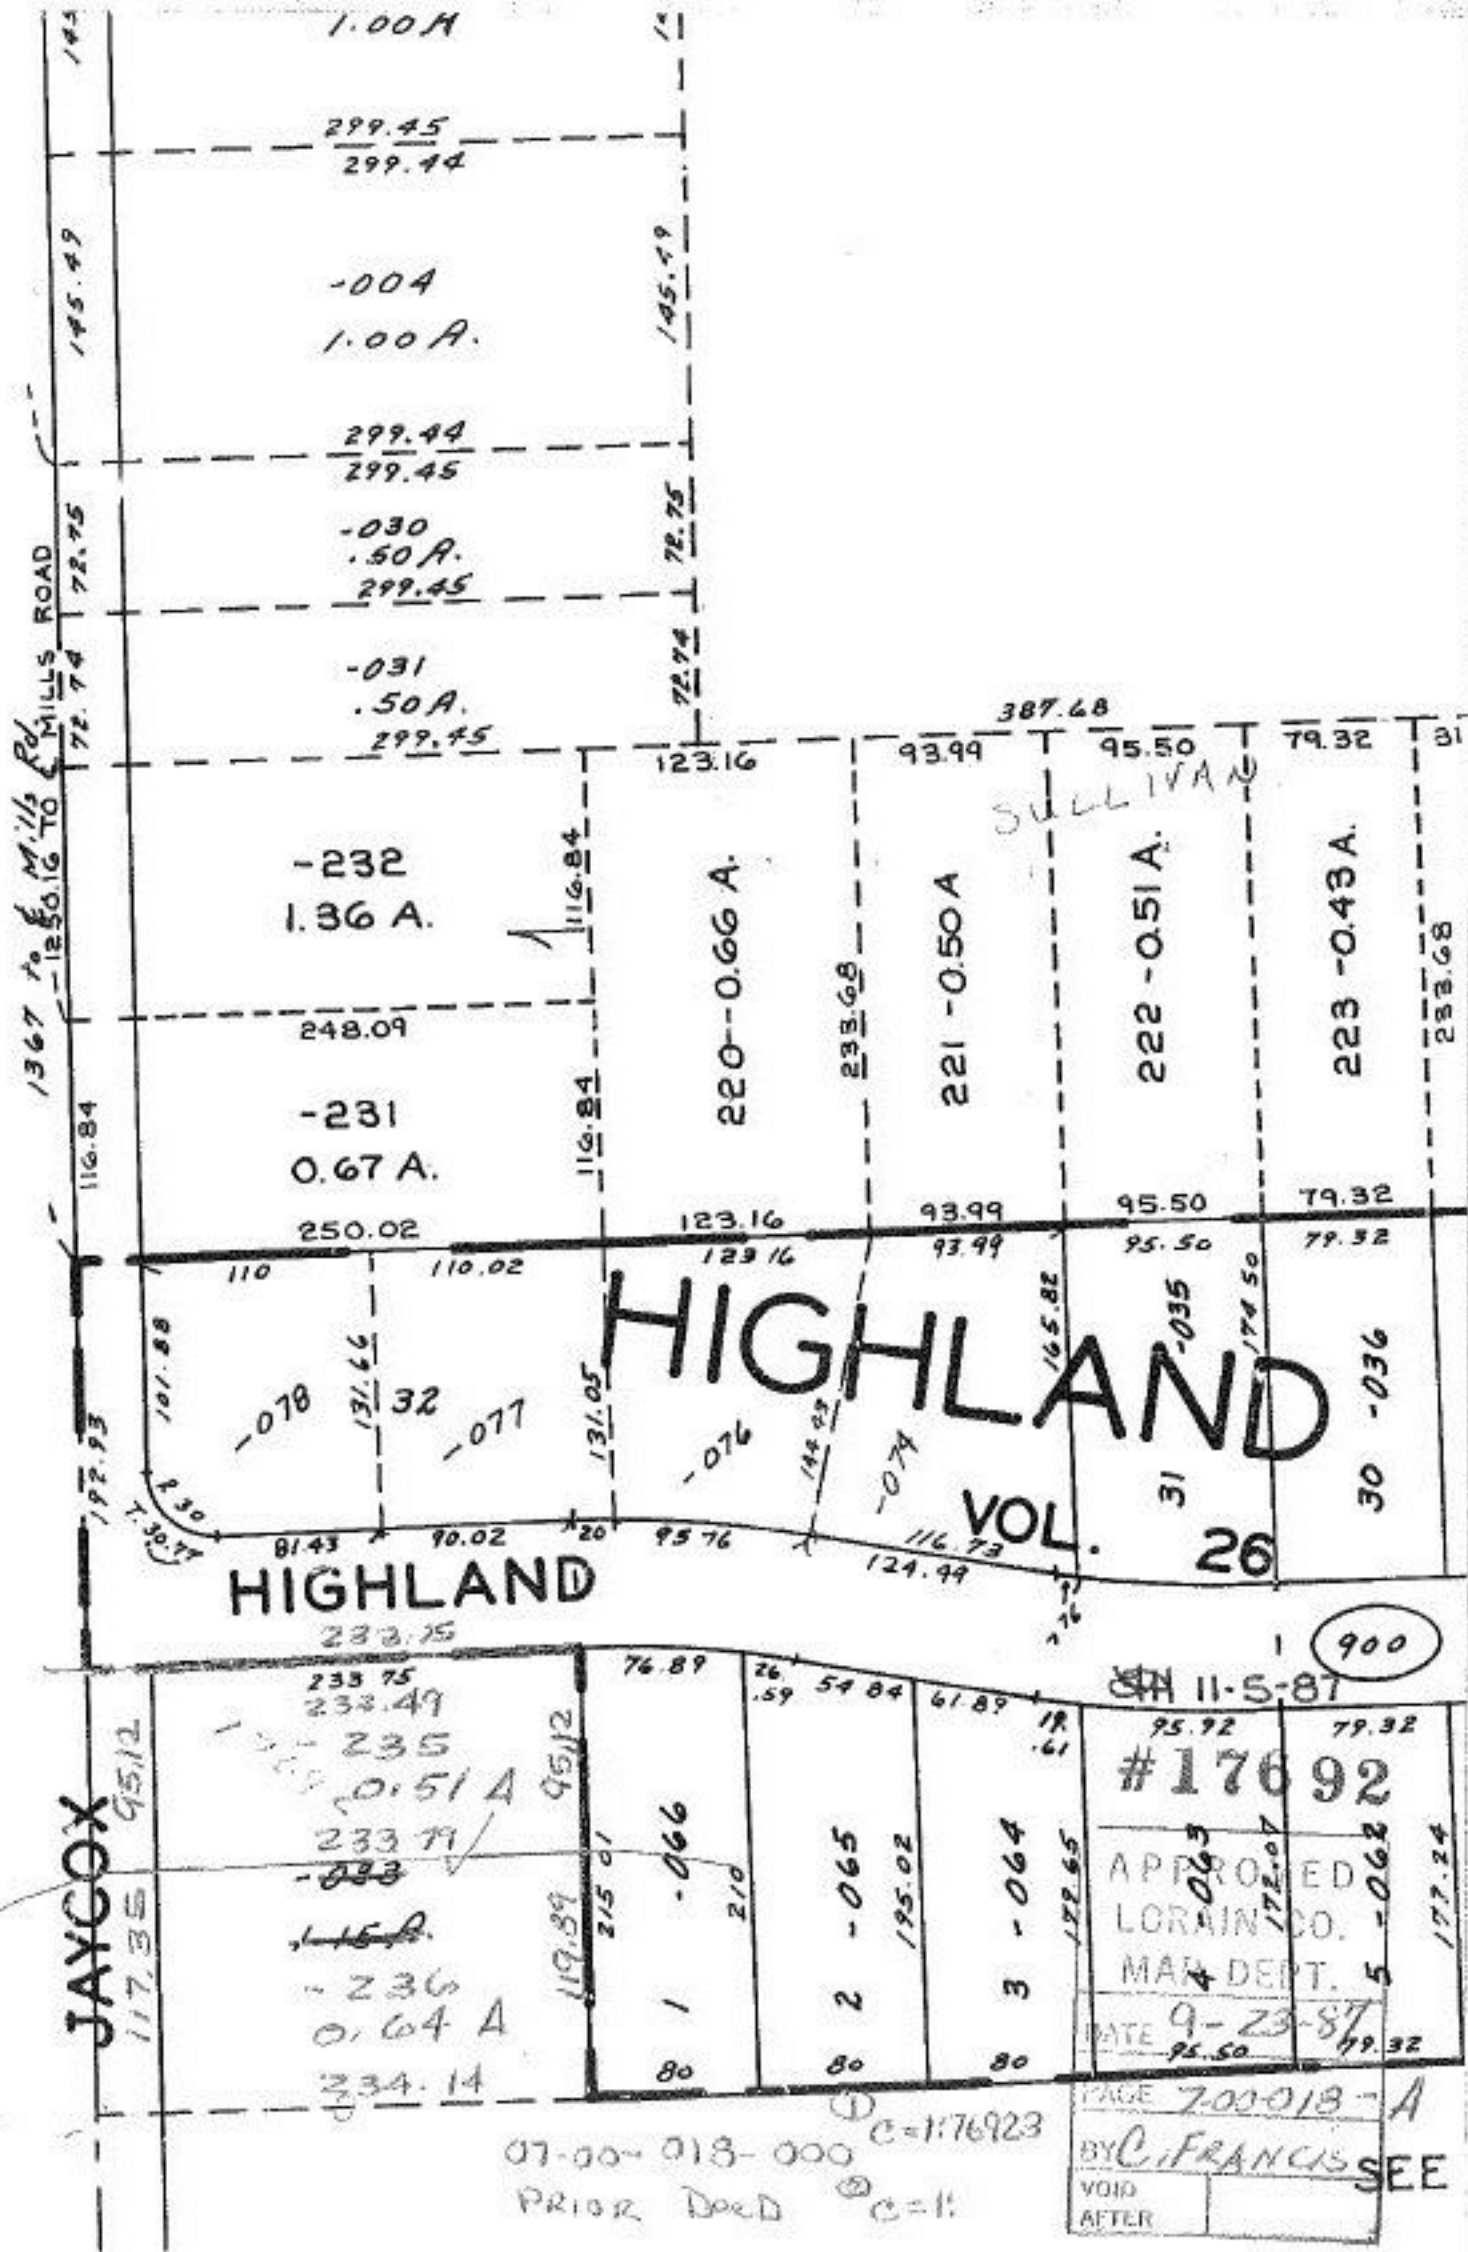

JAYCOX

117.35 95.12

233.75
233.49
235
0.51 A
233.79
-033
1.15 A.
-236
0.64 A
234.14

119.89 215.01

1 - 0.66

76.89
26.59 54.84 61.89
19.61
172.65
3 - 0.64

JAN 11-5-87
#17692
APPROVED
LORAIN CO.
MAR DEPT. 4
DATE 9-23-87
95.50 79.32

07-00-018-000 C=1:76923
PRIOR Deed C=1:

PAGE 7-00-018-A
BY C. FRANCIS
VOID AFTER
SEE