


010	55-008
M F	53-009
011	51-010
012	49-011
AG	LN.
001	NO. 42
002	SUB. -002
003	44-003
FORTHOFER	-004
005	-005
006	107 47-006
007	

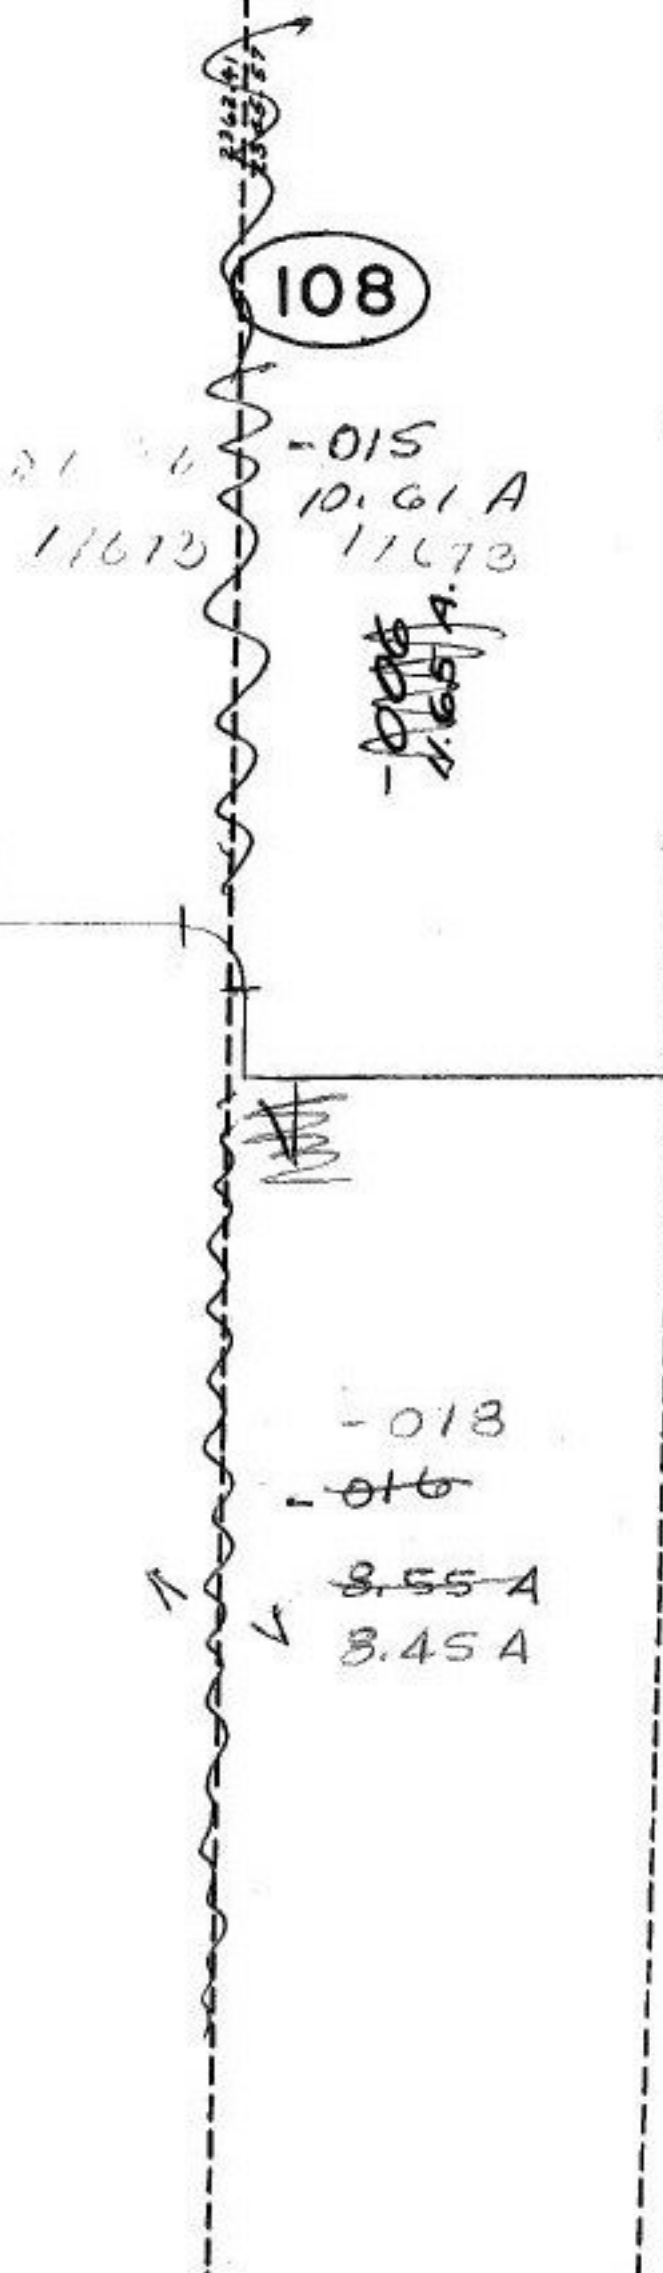

SEE 4-00-015-F

SN 10-29-87
 #17700
 APPROVED
 LORAIN CO.
 MAP DEPT.
 DATE 9-25-87
 PAGE 4-00-015-E
 BY C. FRANCIS
 VOID AFTER 17700