


Pt. -028
Pt. ~~50.79 A.~~
17567

Pt. ~~030~~ - 032
Pt. ~~49.65 A~~ 48.70 A

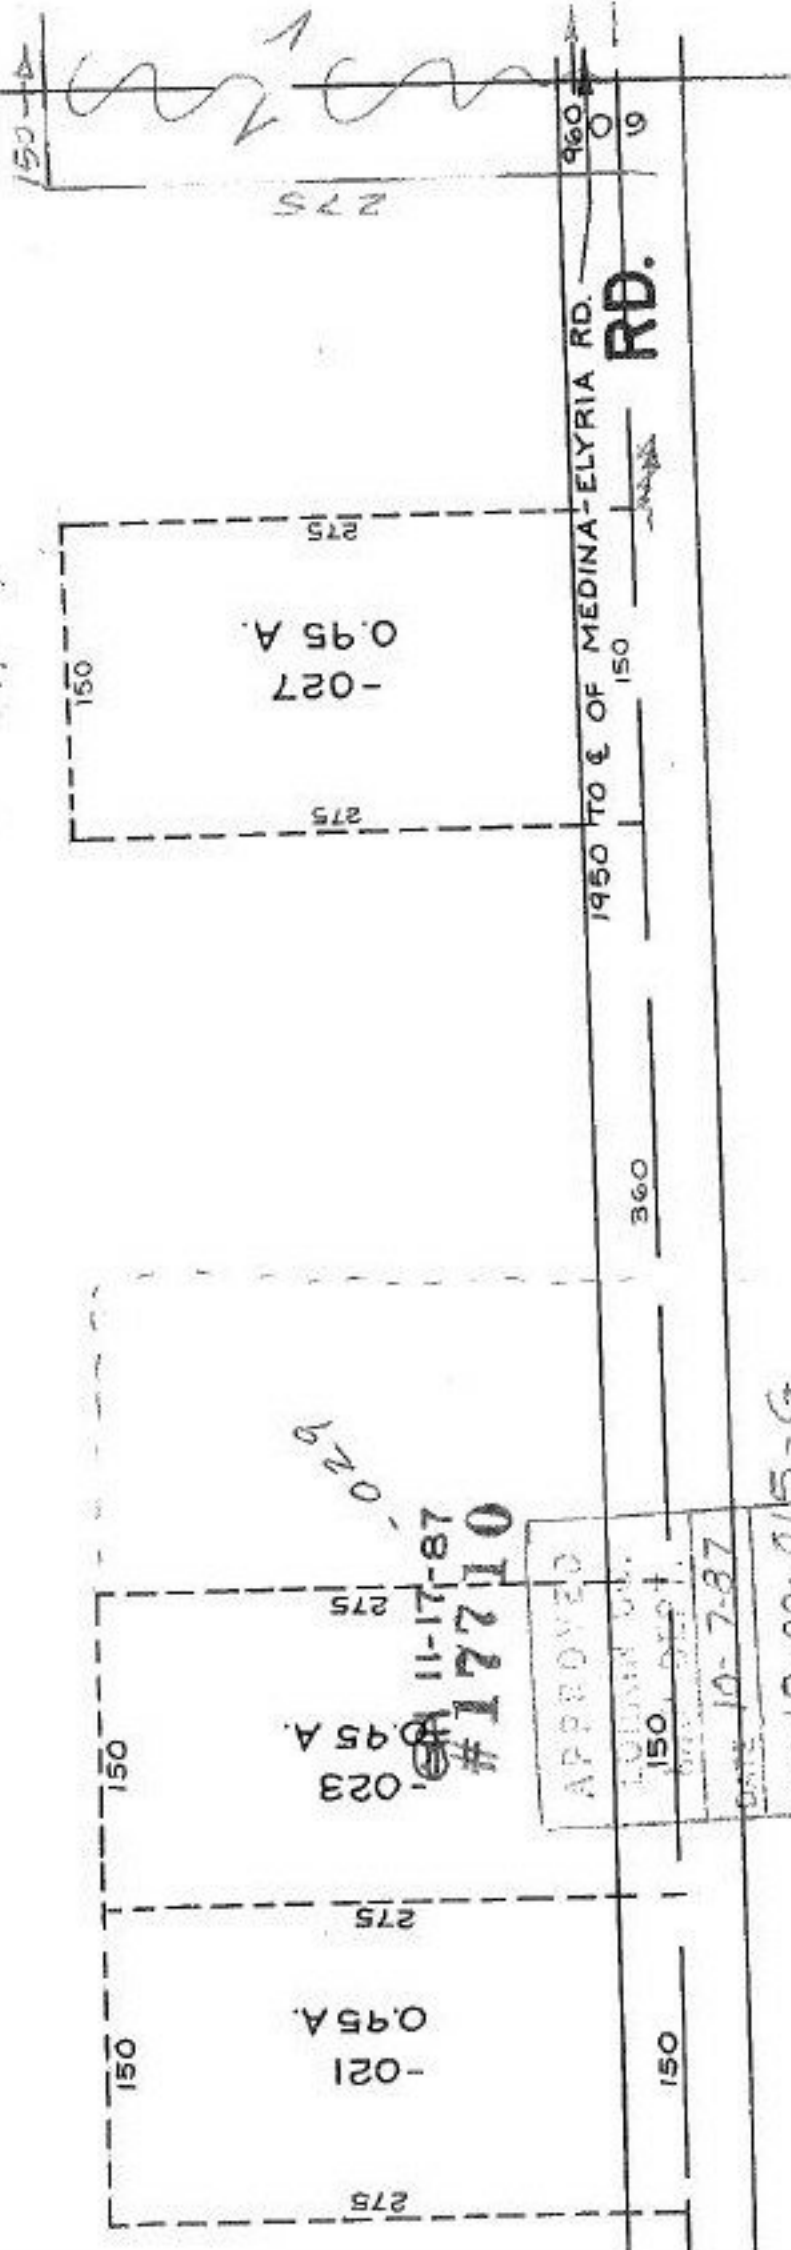

APPROVED
11-17-87
17710
028
0.95 A.

DATE	10-7-87
PAGE	10-00-015-G
BY	C. FRANCIS