


SEE 9-00-004-B

ERST

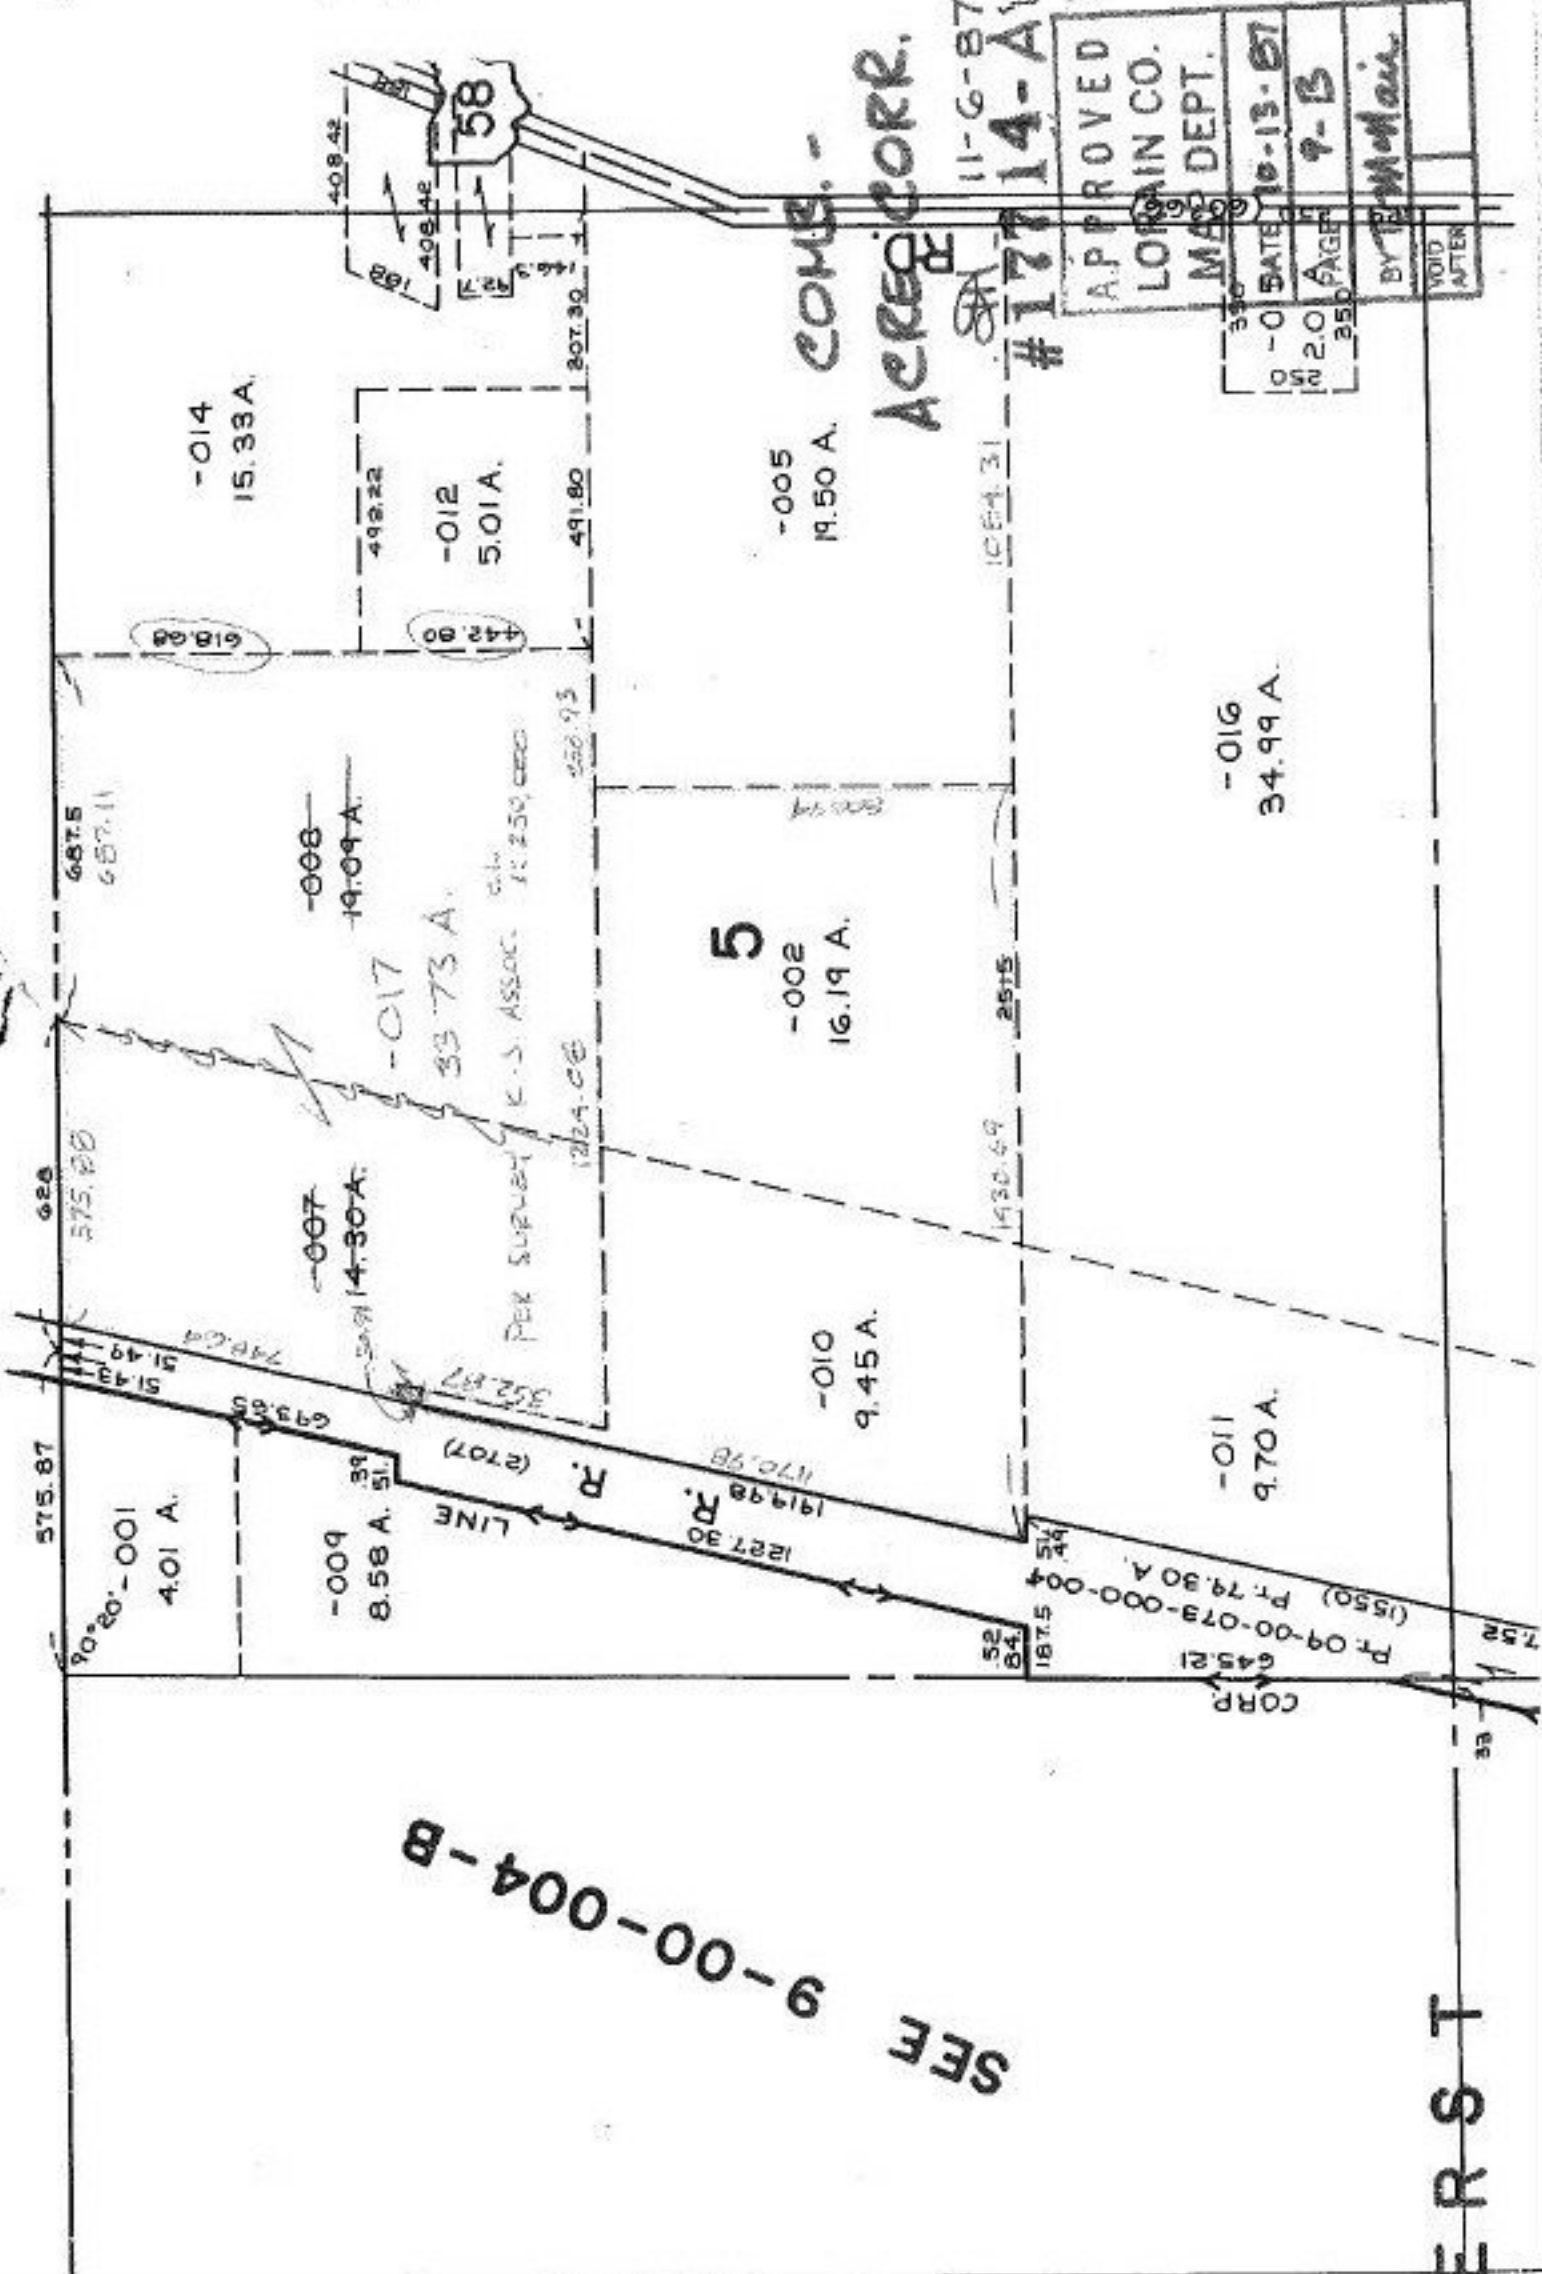

APPROVED	
LORAIN CO.	
MAY DEPT.	
330	0
0	0
2.0	10-13-87
350	PAGER
	9-B
BY <i>McMullen</i>	
VOID	AFTER