
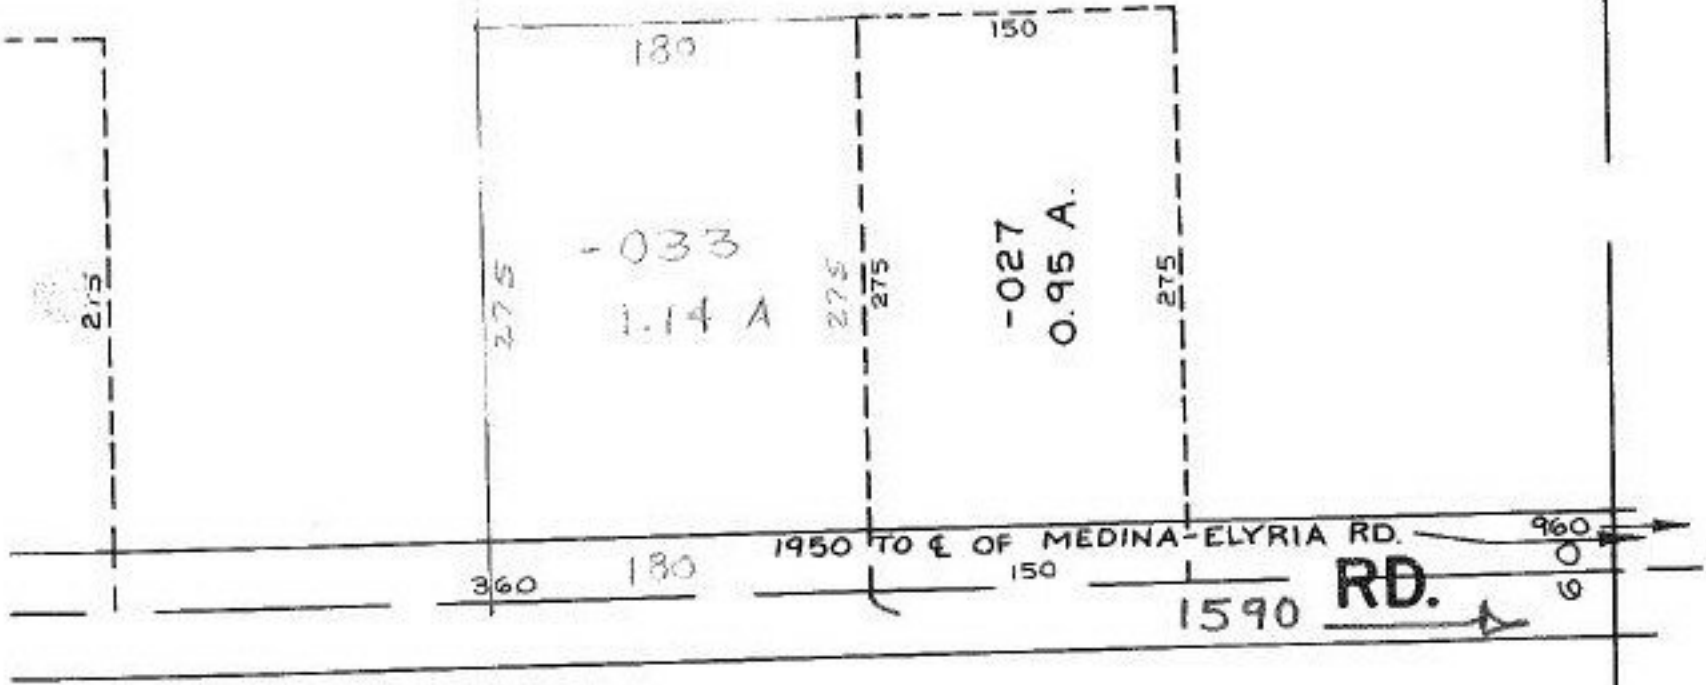


Pt. -028  
r. 50.79 A.

# 17507

Pt. -034  
~~032~~

Pt. 48.70 A.  
47.56 A

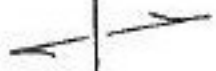

116

Pt. -020  
Pt. 16.86 A.

ON 12-15-87  
# 17727

APPROVED
GRAIN CO.
MAP DEPT.
DATE 10-20-87
NO. 10-00-015-G
BY Carolyn Francis
VOID AFTER 17727

