


SEE 3-00-027-A

①

SN 11-2-87
17735

APPROVED	
LORAIN CO.	
MAP DEPT.	
DATE 10-26-37	
PAGE 3-22-0247	
BY C. GARDNER-FRANCIS	
VOID AFTER	17735

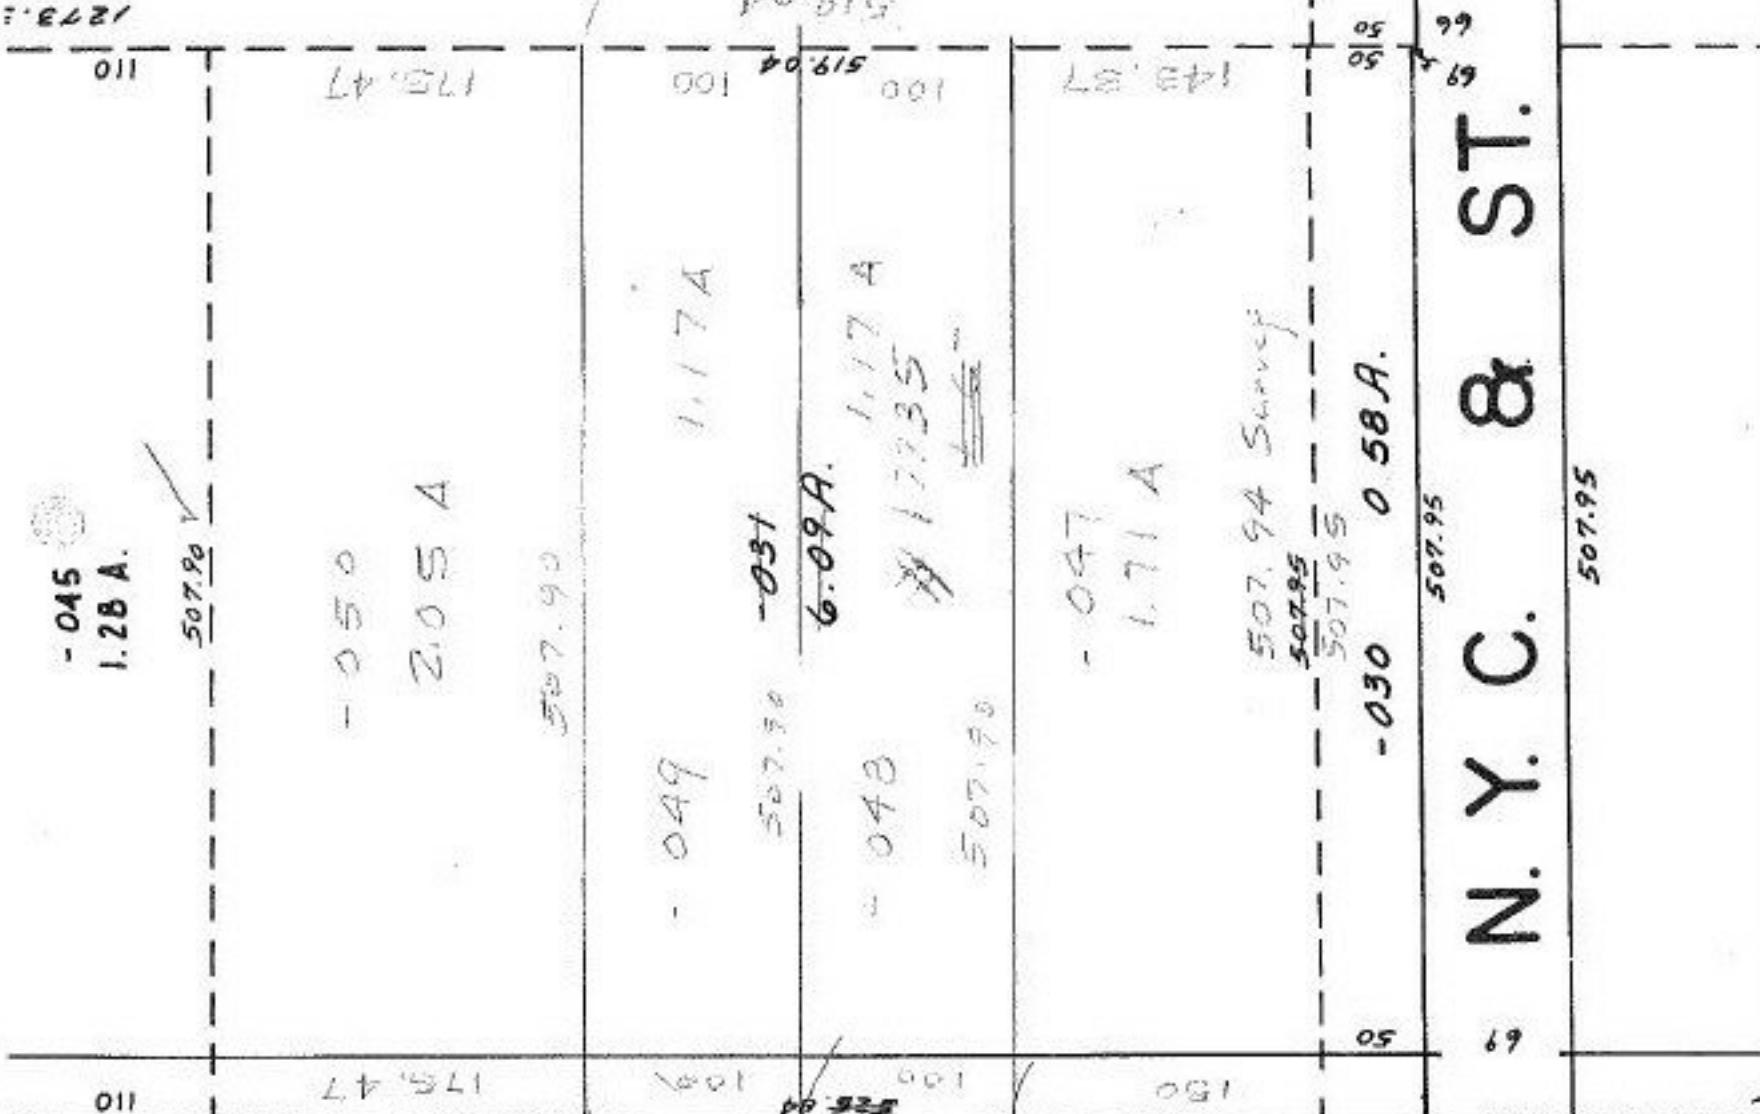

Pl. -001
Pt. 7.752 A.

PRIOR DEED
NOT SURVEYED
1130-596

518.84 Survey

6.09

-035
972 A.

SEE 3-00-027-A

② 525.84
③ 525.47 - Survey

④