


S.E. 16-00-025-A

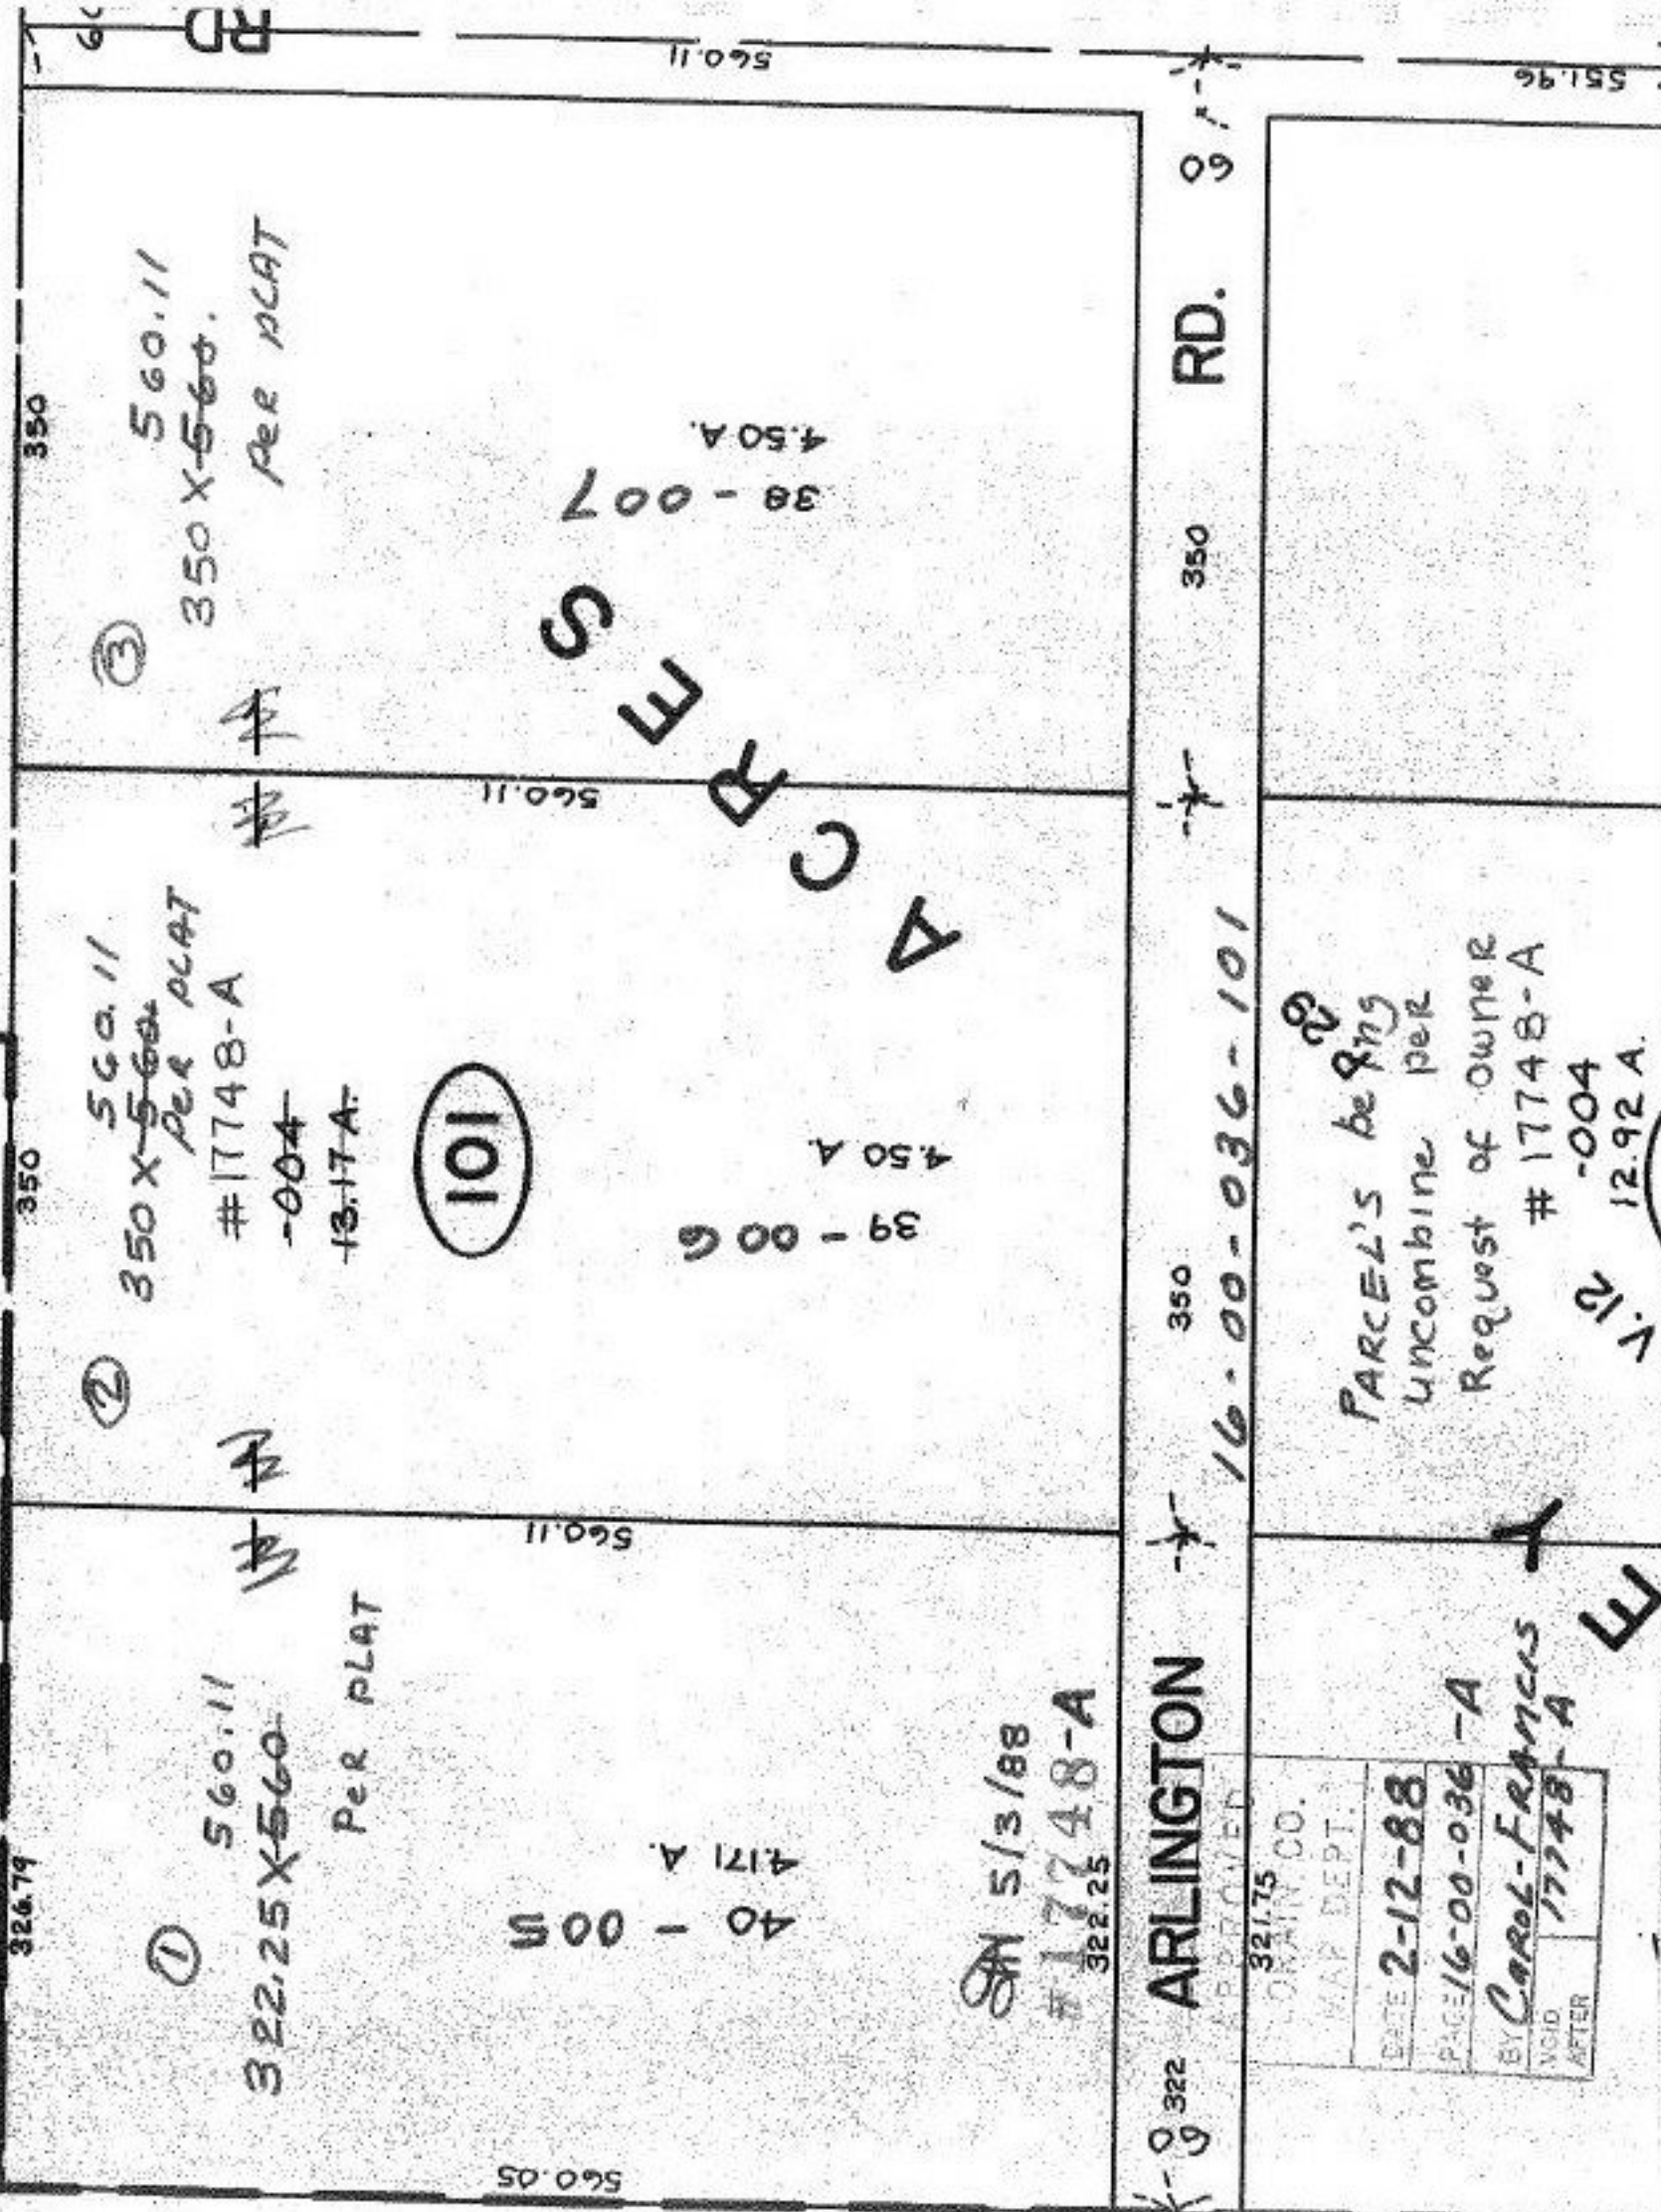

①
322.25 X 560.11
Per PLAT
4.71 A.
40 - 00 IN

②
350 X 560.11
Per PLAT
13.17 A.

③
350 X 560.11
Per PLAT
4.50 A.

101

CROSS SECTION

322 ARLINGTON

16-00-036-101

RD. 97

5/3/88
#17748-A
322.25

APPROVED	321.75
COMAIN CO.	MAP DEPT.
DATE 2-12-88	PAGE 16-00-036-A
BY Carol-Francis	17748-A
VOID AFTER	

PARCEL'S BEING
UNCOMBINE PER
Request of owner
17748-A
-004
12.92 A.