

1776


Done 7-20-68
Jim Lane



1 IN. = 100 FT.

1776

APPROVED
LORAIN CO.
MAP DEPT.
DATE 5-20-68
6-102
BY <i>A. Calbert</i>

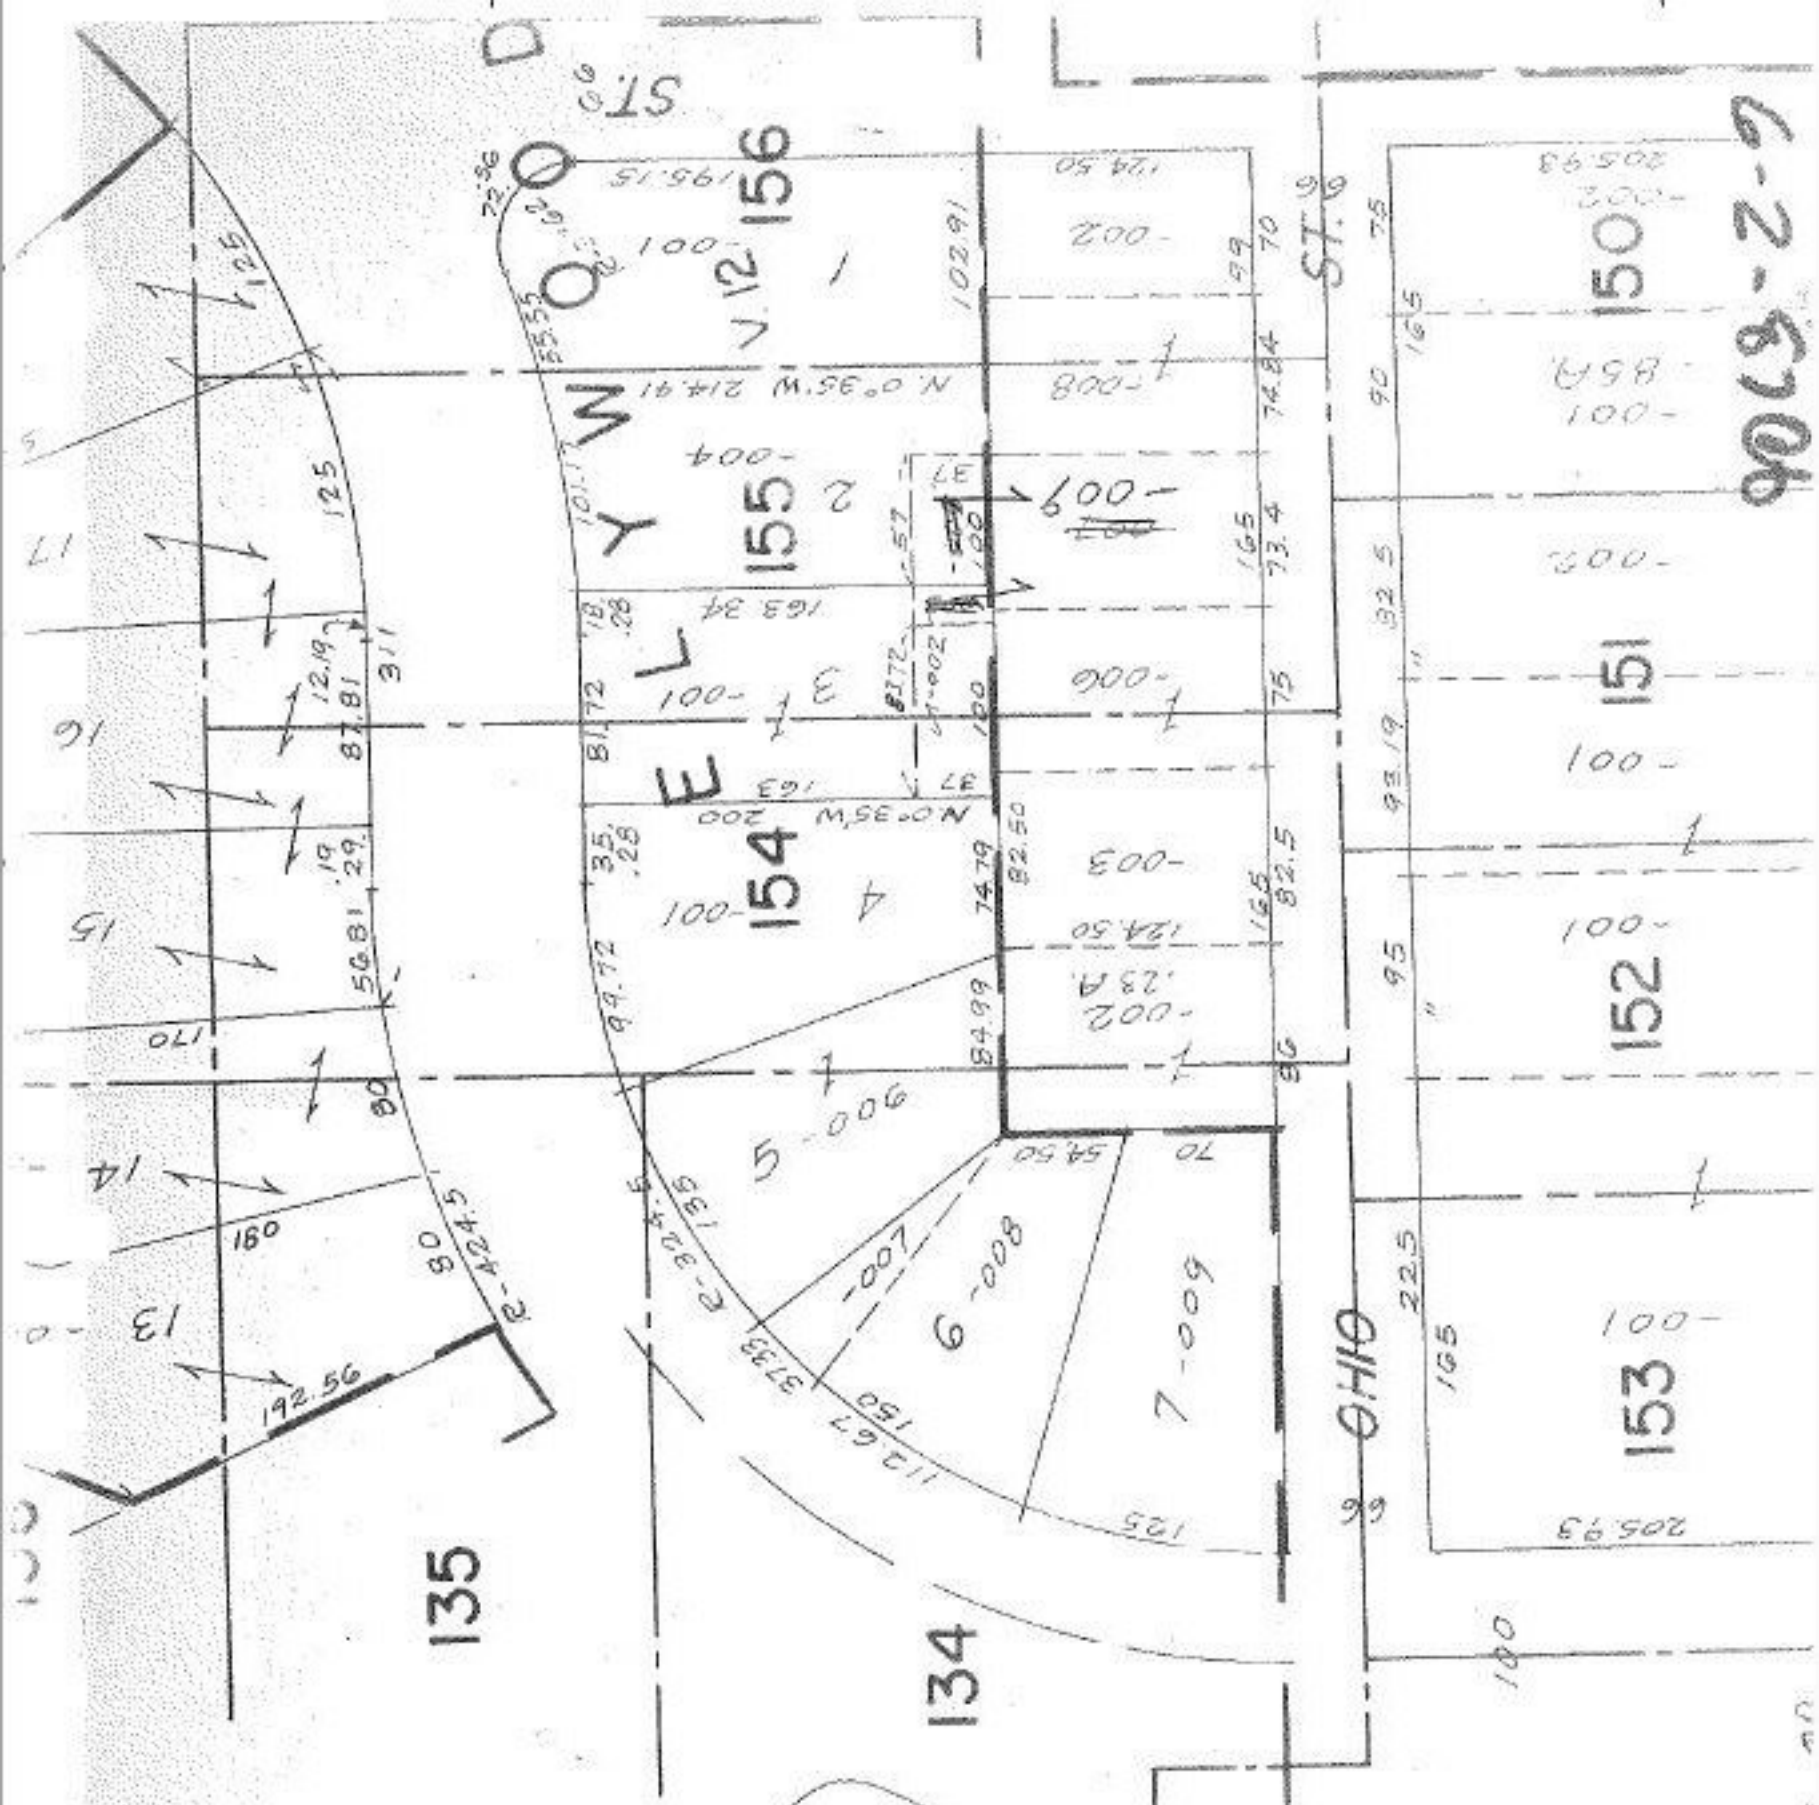

9019-2-9